



Designed:	EEC
Drawn:	EEC
Checked:	MLR
Edit:	12-5-2017

Title:	50021 - UHLAND RD AT BLANCO RIVER SITE AERIAL VIEW
	Filepath: P:\A637 Hays County TX Low Water Crossing System\AutoCAD\AS BUILT\FLASHERS\50021 - UHLAND RD AT BLANCO RIVER\50021 - UHLAND RD.dwg

Scale:	NOT TO SCALE
Copy:	AS BUILT

Project No:	A637
Drawing:	1




Designed:	EEC
Drawn:	EEC
Checked:	MLR
Edit:	12-5-2017

Title:	50021 - UHLAND RD AT BLANCO RIVER MASTER AERIAL VIEW
Filepath:	P:\A637 Hays County TX Low Water Crossing System\AutoCAD\AS BUILT\FLASHERS\50021 - UHLAND RD AT BLANCO RIVER\50021 - UHLAND RD.dwg

Scale:	NOT TO SCALE
Copy:	AS BUILT

Project No:	A637
Drawing:	2

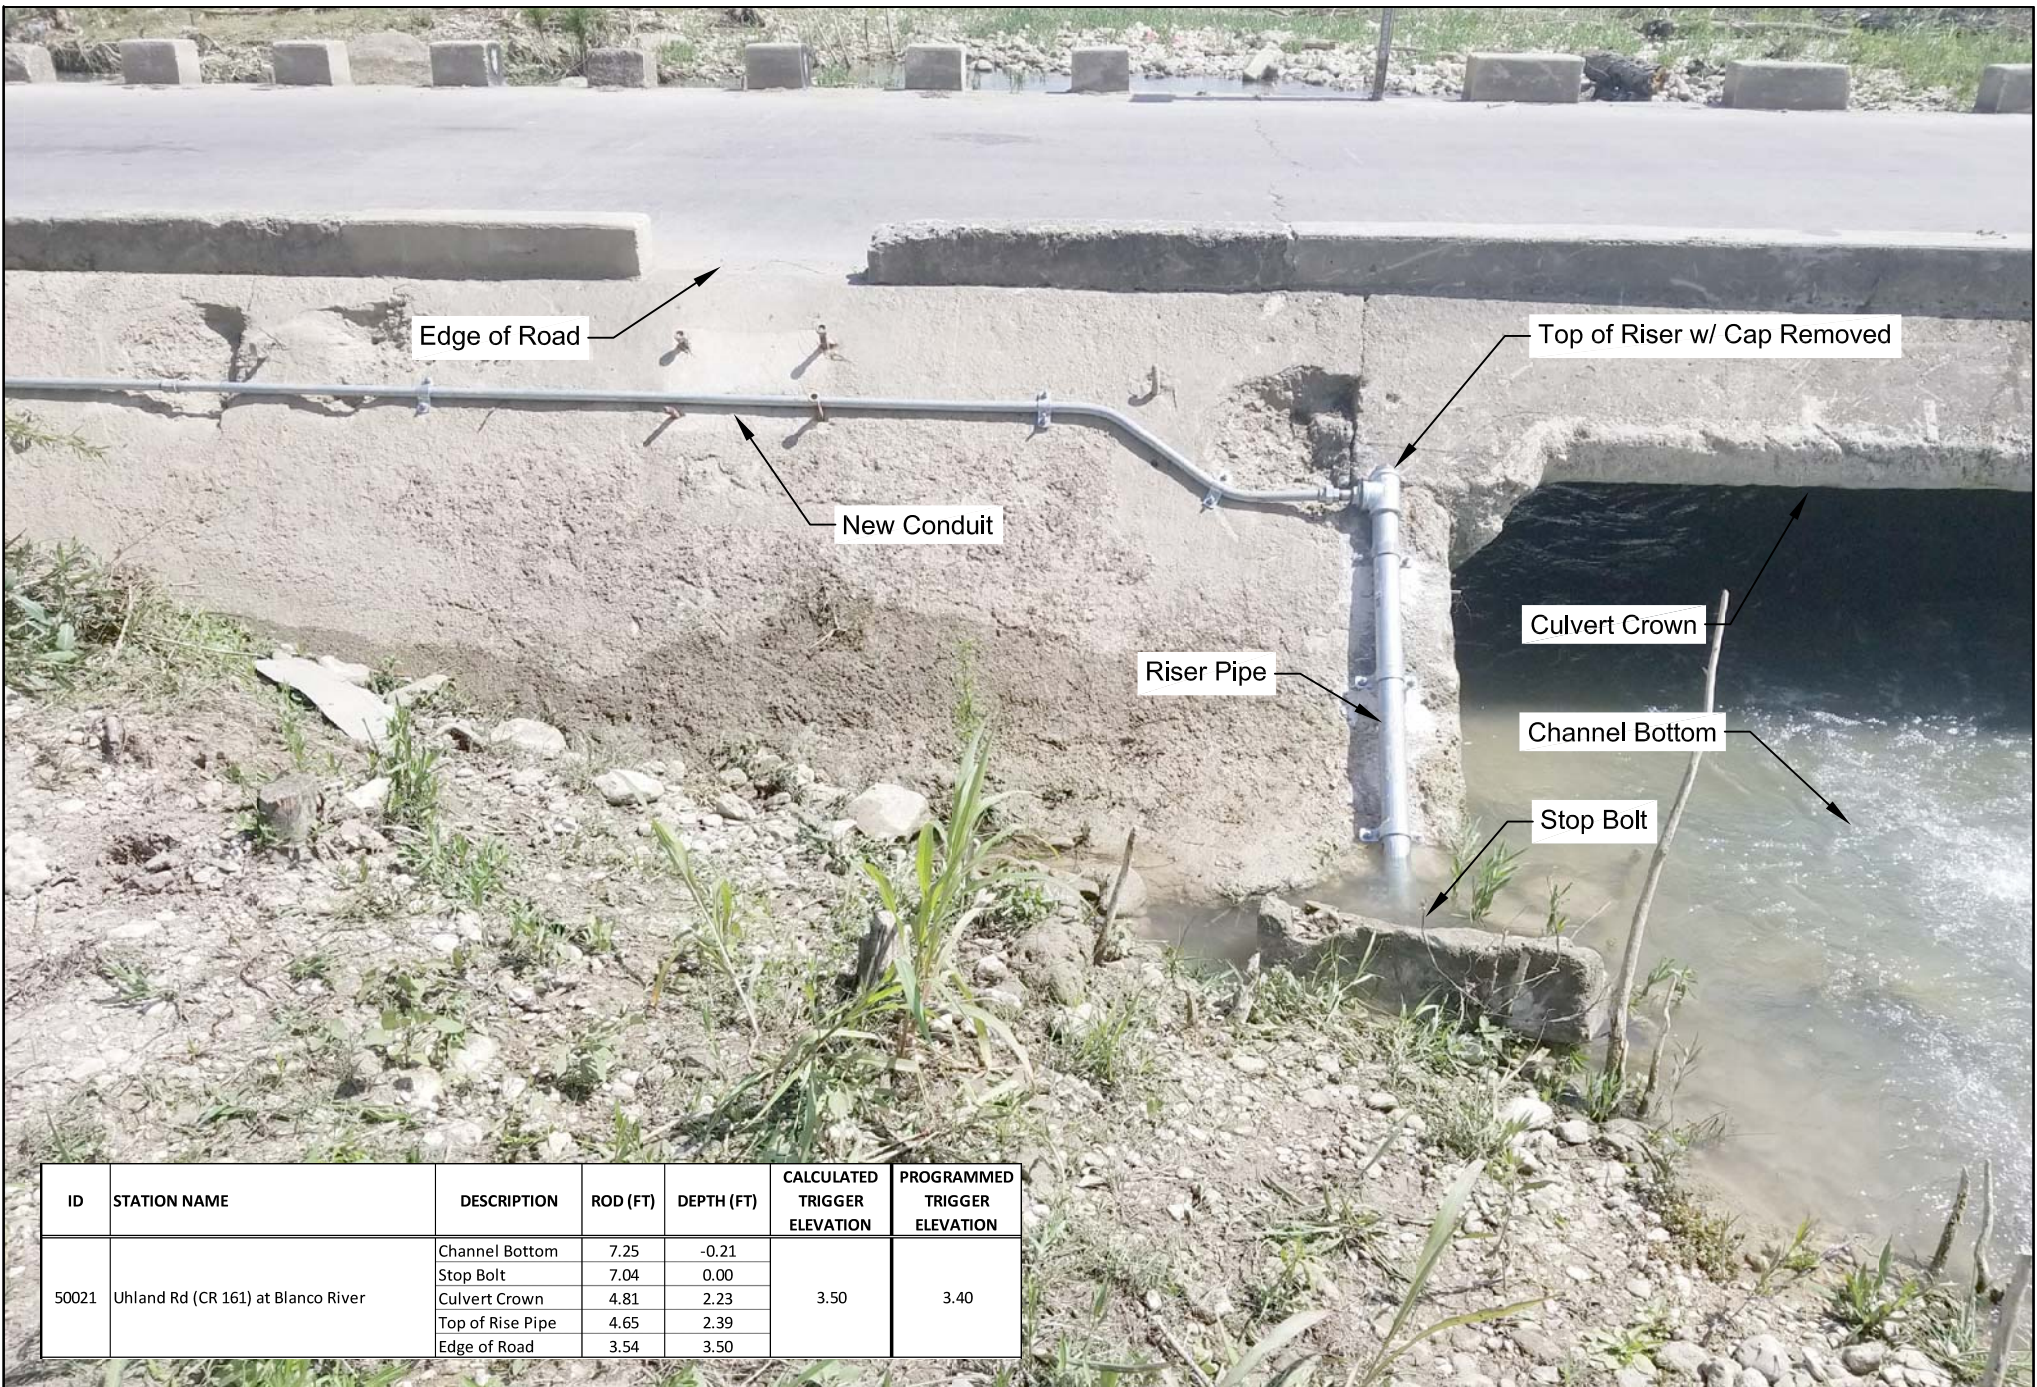

ID	STATION NAME	DESCRIPTION	ROD (FT)	DEPTH (FT)	CALCULATED TRIGGER ELEVATION	PROGRAMMED TRIGGER ELEVATION
50021	Uhland Rd (CR 161) at Blanco River	Channel Bottom	7.25	-0.21	3.50	3.40
		Stop Bolt	7.04	0.00		
		Culvert Crown	4.81	2.23		
		Top of Rise Pipe	4.65	2.39		
		Edge of Road	3.54	3.50		



Designed: EEC
 Drawn: EEC
 Checked: MLR
 Edit: 12-5-2017

Title: 50021 - UHLAND RD AT BLANCO RIVER SURVEY & RISER DETAIL
 Filepath: P:\A637 Hays County TX Low Water Crossing System\AutoCAD\AS BUILT\FLASHERS\50021 - UHLAND RD AT BLANCO RIVER\50021 - UHLAND RD.dwg

Scale: NOT TO SCALE
 Copy: AS BUILT

Project No: A637
 Drawing: 3



Designed: EEC
 Drawn: EEC
 Checked: MLR
 Edit: 12-5-2017

Title: 50021 - UHLAND RD AT BLANCO RIVER
 CONDUIT DETAIL #1
 Filepath: P:\A637 Hays County TX Low Water Crossing System\AutoCAD\AS BUILT\FLASHERS\50021 - UHLAND RD AT BLANCO RIVER\50021 - UHLAND RD.dwg

Scale: NOT TO SCALE
 Copy: AS BUILT

Project No: A637
 Drawing: 4



Designed:	EEC
Drawn:	EEC
Checked:	MLR
Edt:	12-5-2017

Title:	50021 - UHLAND RD AT BLANCO RIVER CONDUIT DETAIL #2
Filepath:	P:\A637 Hays County TX Low Water Crossing System\AutoCAD\AS BUILT\FLASHERS\50021 - UHLAND RD AT BLANCO RIVER\50021 - UHLAND RD.dwg

Scale:	NOT TO SCALE
Copy:	AS BUILT

Project No:	A637
Drawing:	5

