



Designed:	EEC
Drawn:	EEC
Checked:	MLR
Edt:	1-9-2018

Title:	50022 - HILLIARD RD AT SINK CREEK TRIBUTARY SITE AERIAL VIEW
Filepath:	P:\A637 Hays County TX Low Water Crossing System\AutoCADAS BUILT\FLASHERS\50022 - HILLIARD RD\50022 - HILLIARD RD.dwg

Scale:	NOT TO SCALE
Copy:	AS BUILT

Project No:	A637
Drawing:	1




Designed:	EEC
Drawn:	EEC
Checked:	MLR
Edit:	1-9-2018

Title:	50022 - HILLIARD RD AT SINK CREEK TRIBUTARY MASTER AERIAL VIEW
Filepath:	P:\A637 Hays County TX Low Water Crossing System\AutoCADAS BUILT\FLASHERS\50022 - HILLIARD RD\50022 - HILLIARD RD.dwg

Scale:	NOT TO SCALE
Copy:	AS BUILT

Project No:	A637
Drawing:	2

ID	STATION NAME	DESCRIPTION	ROD (FT)	DEPTH (FT)	CALCULATED TRIGGER ELEVATION	PROGRAMMED TRIGGER ELEVATION
50022	Hilliard Rd (CR 222) at Sink Creek Tributary	Channel Bottom	8.14	-0.62	2.48	2.38
		Stop Bolt	7.52	0.00		
		Top of Riser	6.04	1.48		
		Culvert Crown	5.69	1.83		
		Edge of Road	5.04	2.48		

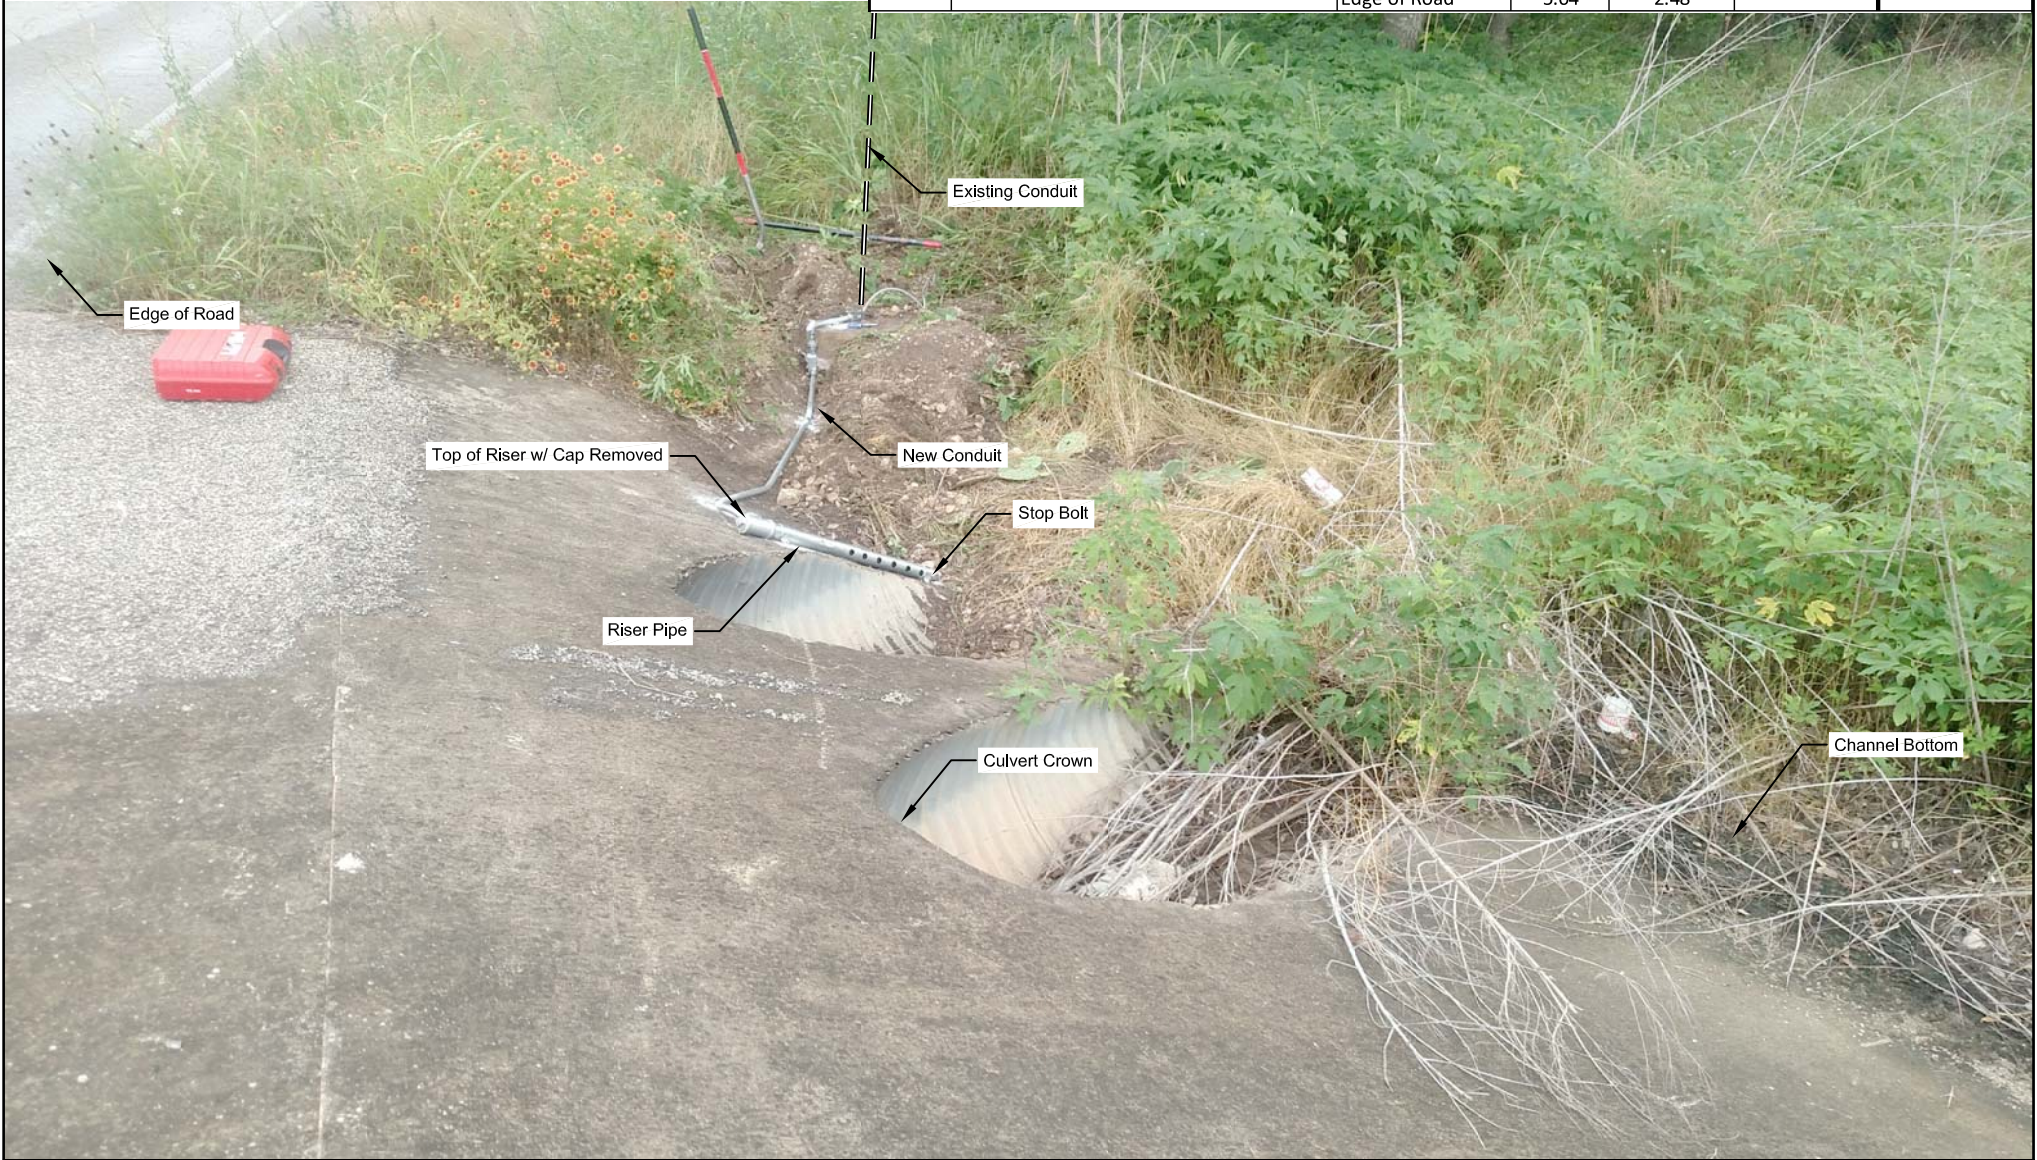


Designed:	EEC
Drawn:	EEC
Checked:	MLR
Edit:	1-9-2018

Title:	50022 - HILLIARD RD AT SINK CREEK TRIBUTARY SURVEY & RISER DETAIL
Filepath:	P:\A637 Hays County TX Low Water Crossing System\AutoCADAS BUILT\FLASHERS\50022 - HILLIARD RD\50022 - HILLIARD RD.dwg

Scale:	NOT TO SCALE
Copy:	AS BUILT

Project No:	A637
Drawing:	3

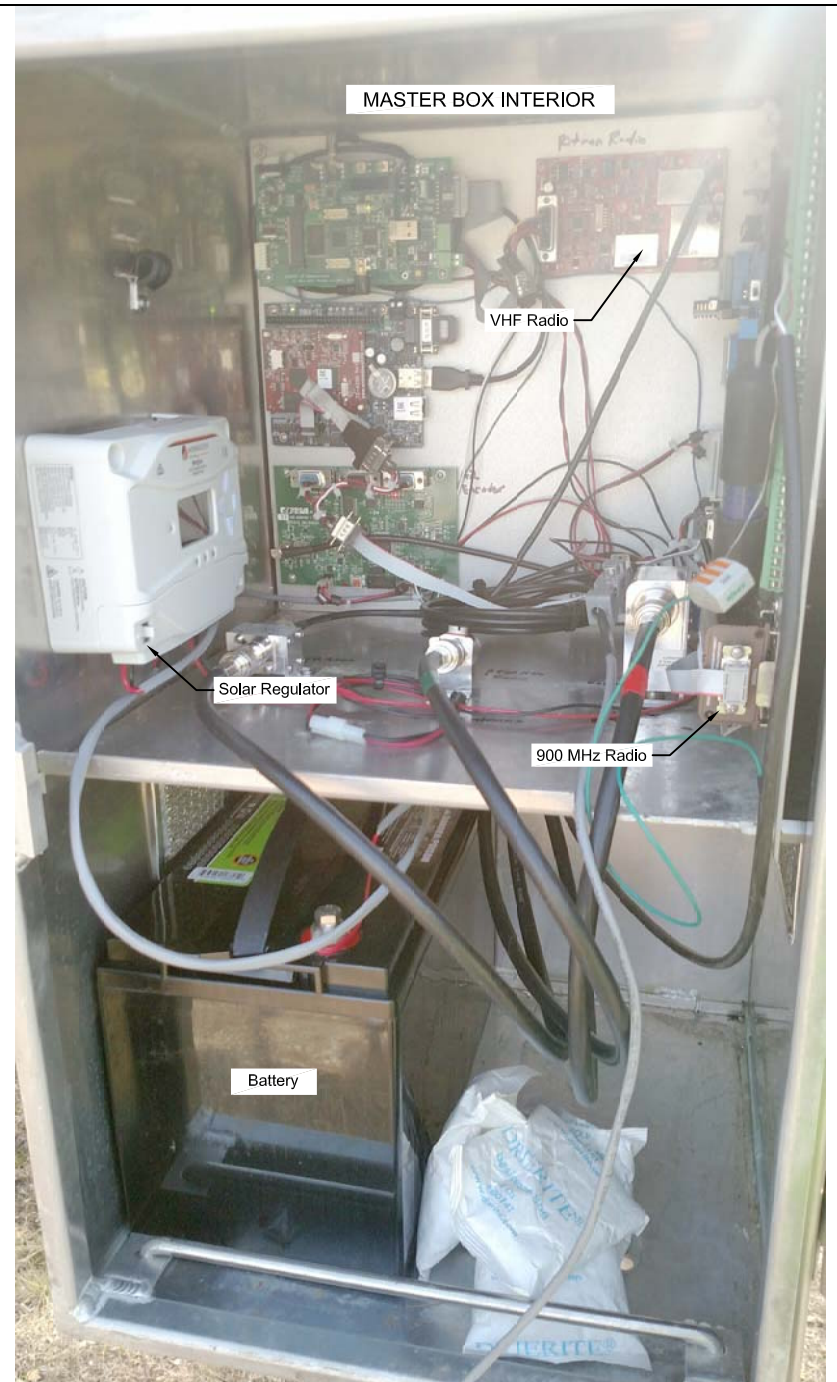



Designed:	EEC
Drawn:	EEC
Checked:	MLR
Edt:	1-9-2018

Title:	50022 - HILLIARD RD AT SINK CREEK TRIBUTARY MASTER DETAILS
Filepath:	P:\A637 Hays County TX Low Water Crossing System\AutoCADAS BUILT\FLASHERS\50022 - HILLIARD RD\50022 - HILLIARD RD.dwg


Scale:	NOT TO SCALE
Copy:	AS BUILT

Project No:	A637
Drawing:	4

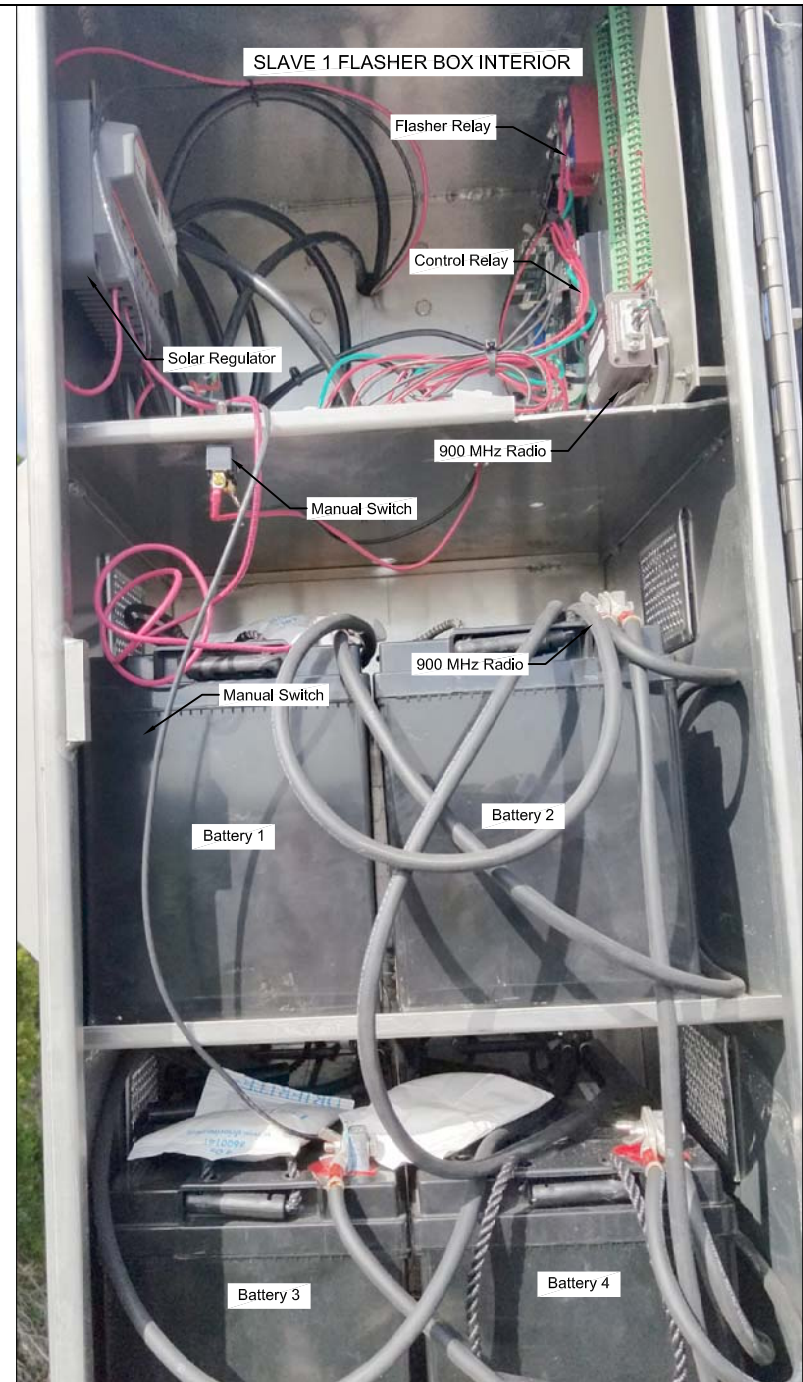

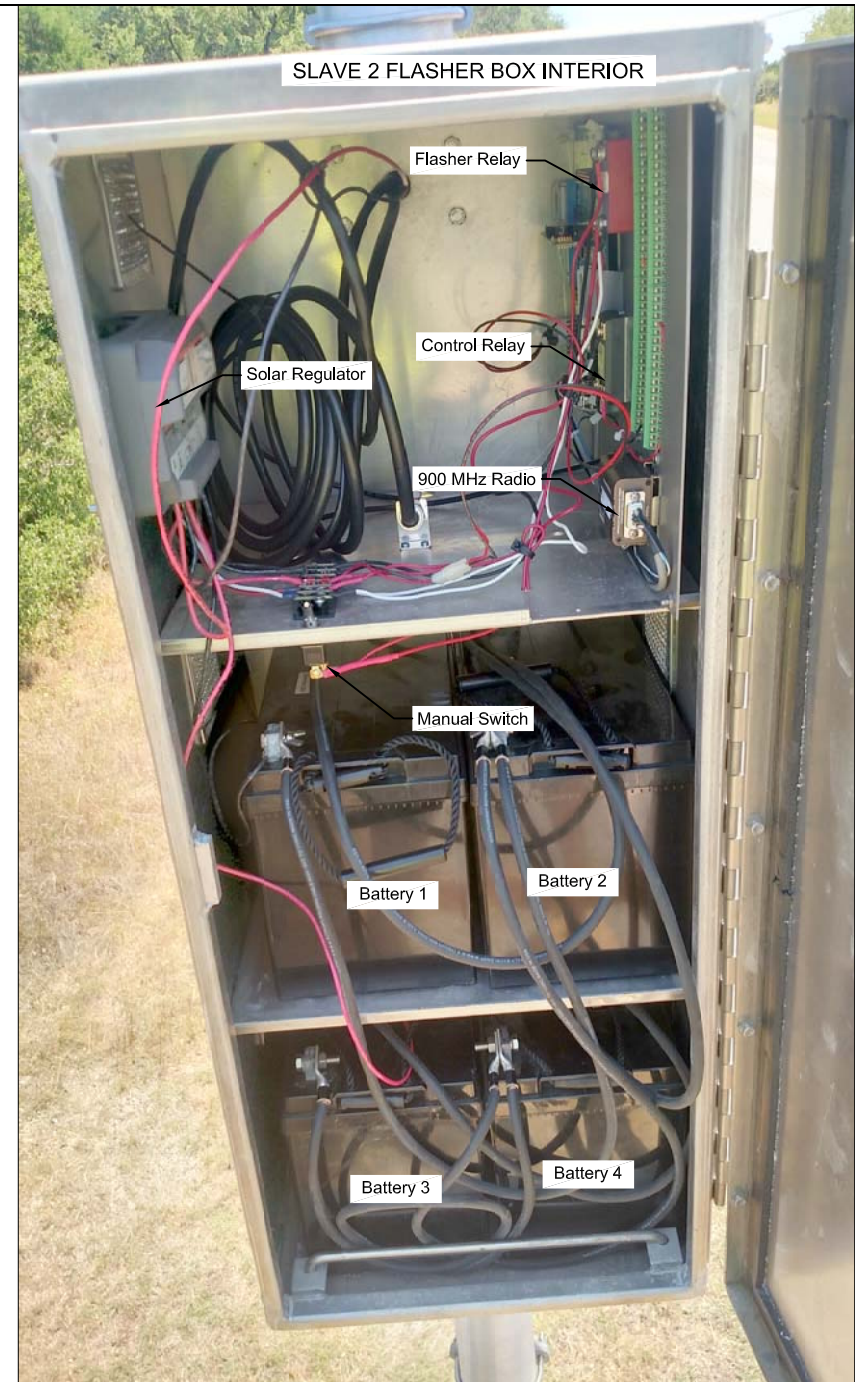



	Designed: EEC	Title: 50022 - HILLIARD RD AT SINK CREEK TRIBUTARY RAIN GAGE DETAIL	Scale: NOT TO SCALE	Project No: A637
	Drawn: EEC		Copy: AS BUILT	Drawing: 7
	Checked: MLR			
	Edit: 1-9-2018		Filepath: P:\A637 Hays County TX Low Water Crossing System\AutoCADAS BUILT\FLASHERS\50022 - HILLIARD RD\50022 - HILLIARD RD.dwg	