

50024

Draw a dimension for your mark



Google Earth



Designed:	EEC
Drawn:	EEC
Checked:	MLR
Edit:	2-9-2018

Title:	50024 - POST ROAD AT BLANCO RIVER SITE AERIAL VIEW
Filepath:	P:\A637 Hays County TX Low Water Crossing System\AutoCADAS BUILT\FLASHERS\50024 - POST ROAD AT BLANCO RIVER\50024 - POST ROAD AT BLANCO RIVER.dwg

Scale:	NOT TO SCALE
Copy:	AS BUILT

Project No:	A637
Drawing:	1



NOTE: AERIAL IMAGE DOES NOT SHOW NEW BRIDGE COMPLETED IN DECEMBER 2017




Designed:	EEC
Drawn:	EEC
Checked:	MLR
Edit:	2-9-2018

Title:	50024 - POST ROAD AT BLANCO RIVER MASTER AERIAL VIEW
Filepath:	P:\A637 Hays County TX Low Water Crossing System\AutoCAD\AS BUILT\FLASHERS\50024 - POST ROAD AT BLANCO RIVER\50024 - POST ROAD AT BLANCO RIVER.dwg

Scale:	NOT TO SCALE
Copy:	AS BUILT

Project No:	A637
Drawing:	2

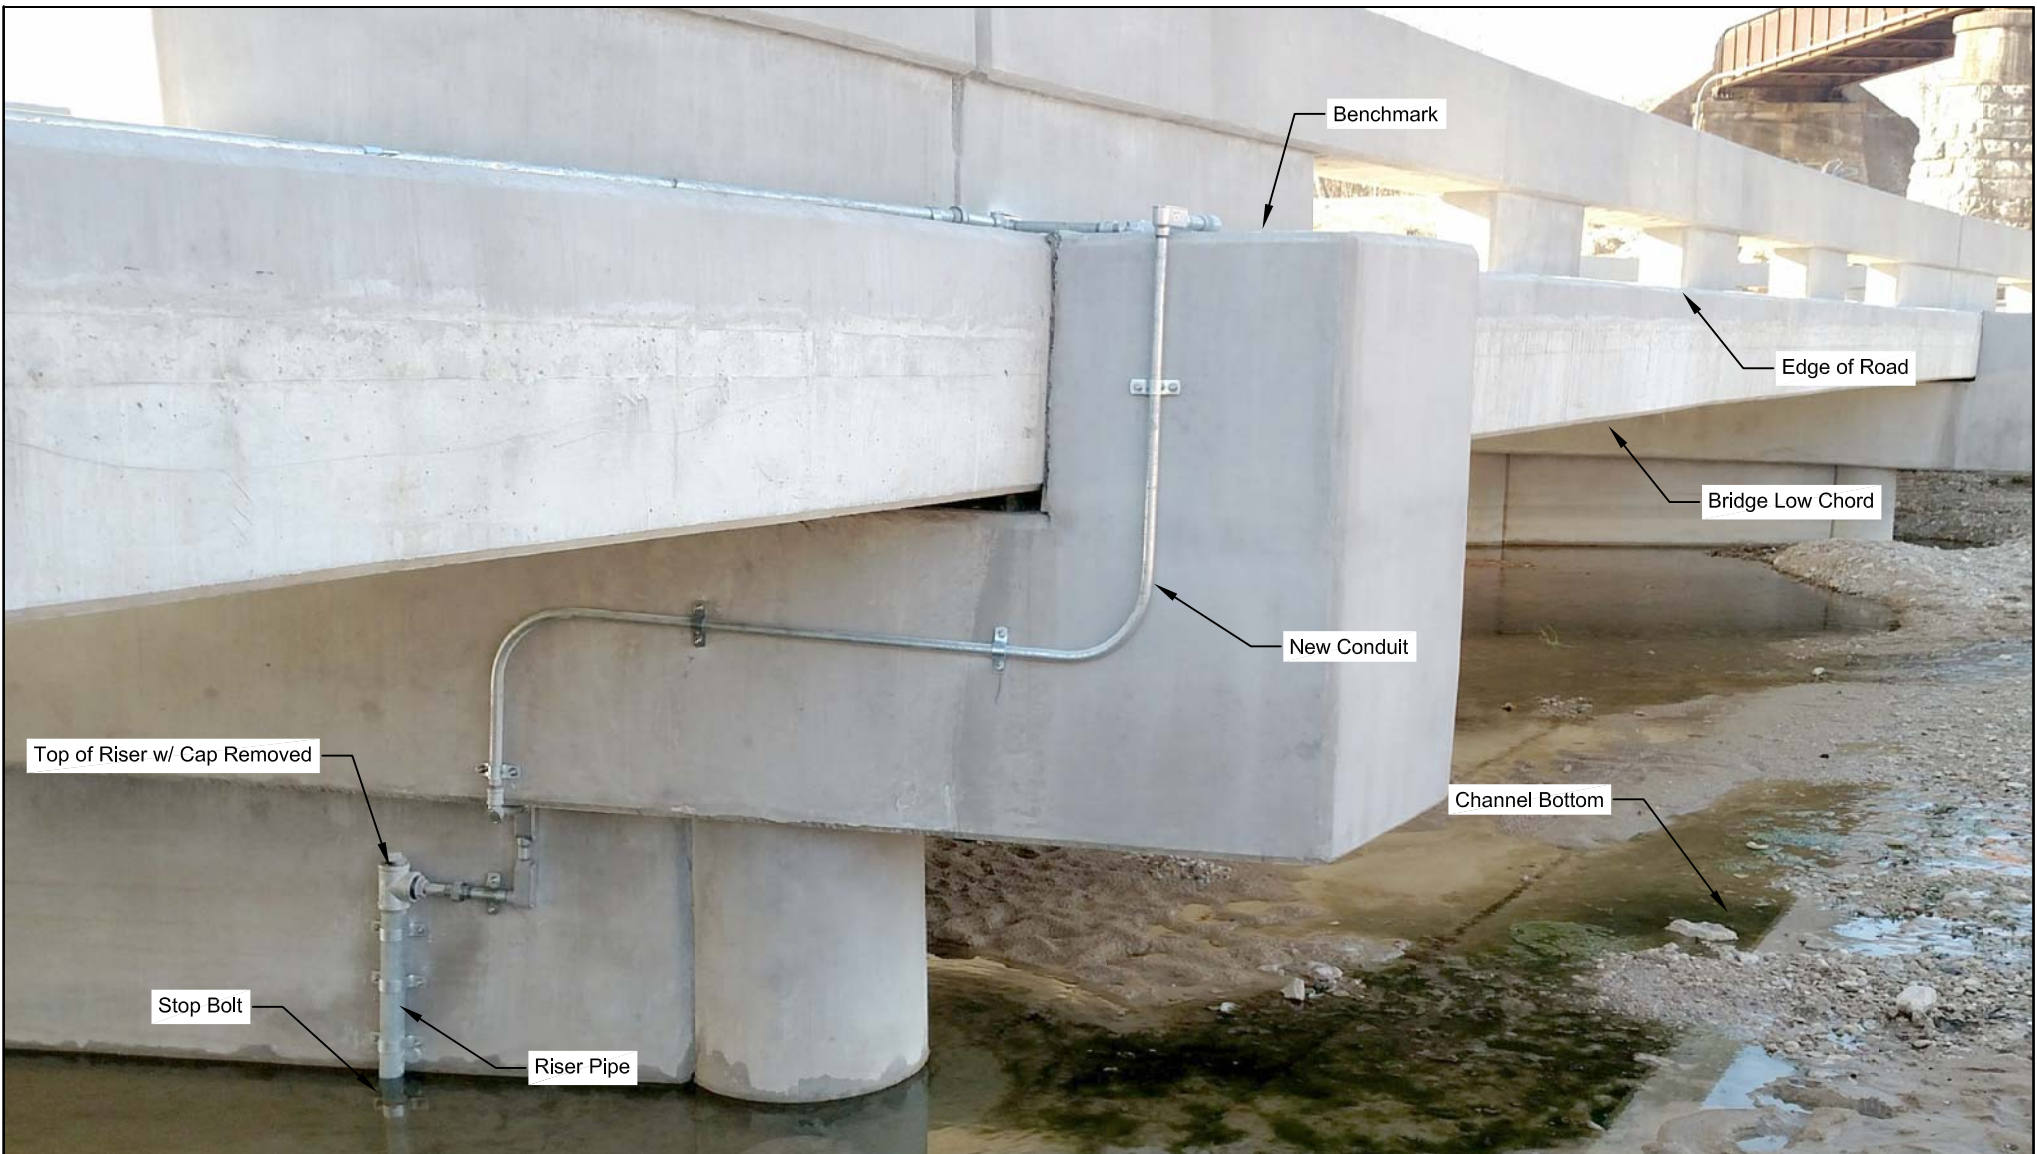

ID	STATION NAME	DESCRIPTION	ROD (FT)	DEPTH (FT)	CALCULATED TRIGGER ELEVATION	PROGRAMMED TRIGGER ELEVATION
50024	Post Road (CR 140) at Blanco River	Channel Bottom	10.67	0.29	7.10	7.00
		Stop Bolt	10.96	0.00		
		BM on bridge	3.86	7.10		
		Bridge Low Chord	5.68	5.28		
		Edge of Road	3.86	7.10		




Designed: EEC
 Drawn: EEC
 Checked: MLR
 Edit: 2-9-2018

Title: 50024 - POST ROAD AT BLANCO RIVER SURVEY & RISER DETAIL
 Filepath: P:\A637 Hays County TX Low Water Crossing System\AutoCAD\AS BUILT\FLASHERS\50024 - POST ROAD AT BLANCO RIVER\50024 - POST ROAD AT BLANCO RIVER.dwg

Scale: NOT TO SCALE
 Copy: AS BUILT

Project No: A637
 Drawing: 3

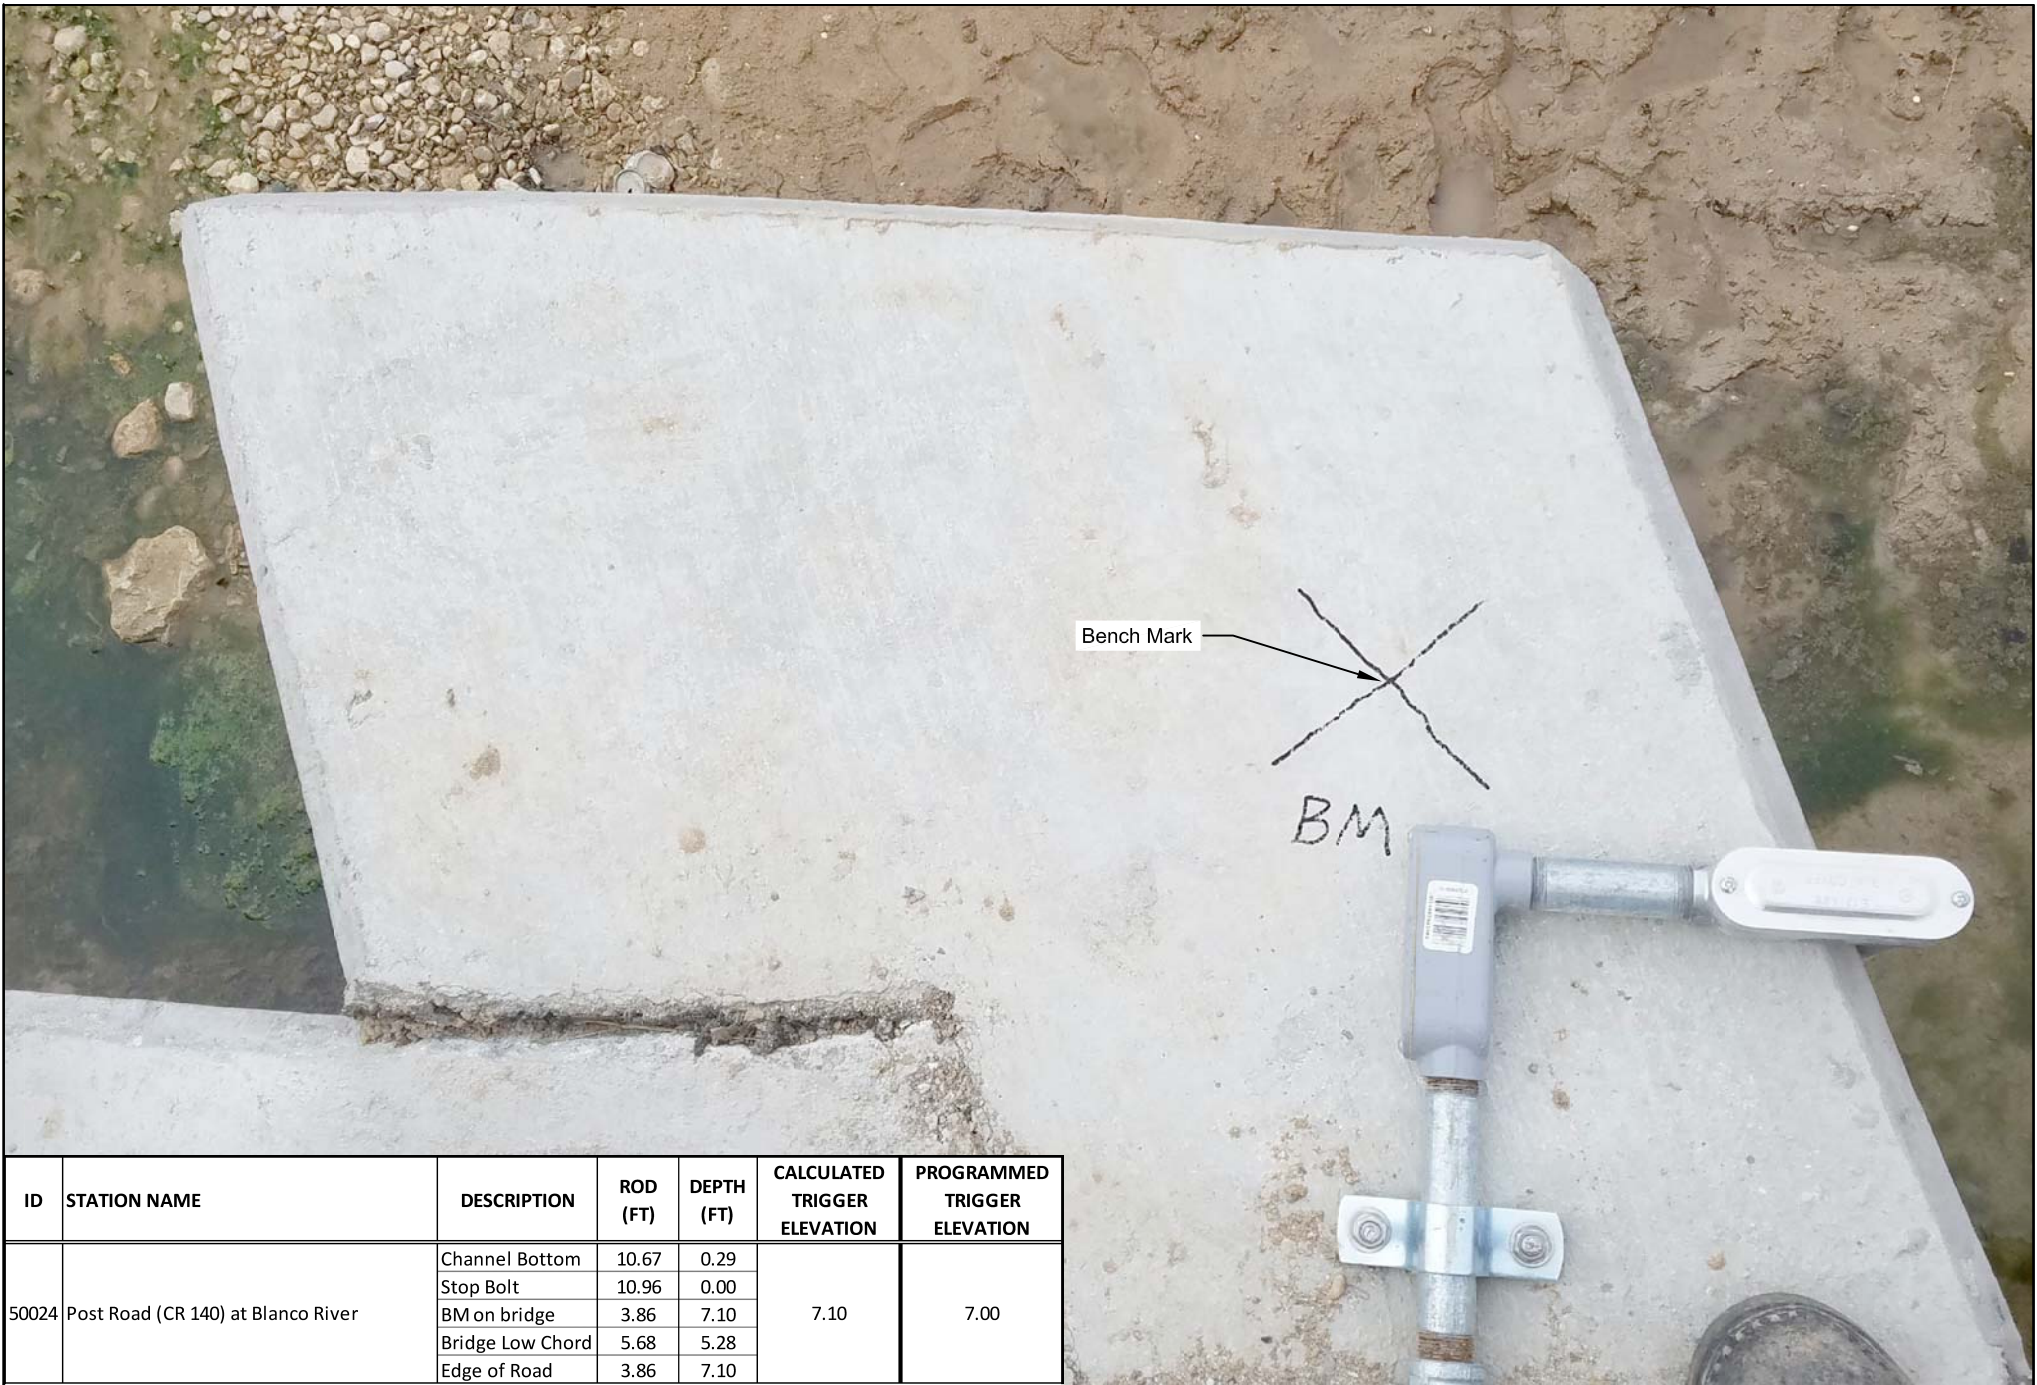

ID	STATION NAME	DESCRIPTION	ROD (FT)	DEPTH (FT)	CALCULATED TRIGGER ELEVATION	PROGRAMMED TRIGGER ELEVATION
50024	Post Road (CR 140) at Blanco River	Channel Bottom	10.67	0.29	7.10	7.00
		Stop Bolt	10.96	0.00		
		BM on bridge	3.86	7.10		
		Bridge Low Chord	5.68	5.28		
		Edge of Road	3.86	7.10		



Designed: EEC
 Drawn: EEC
 Checked: MLR
 Edit: 2-9-2018

Title: 50024 - POST ROAD AT BLANCO RIVER
 BENCHMARK DETAIL

Scale: NOT TO SCALE
 Copy: AS BUILT

Project No: A637
 Drawing: 4

Filepath: P:\A637 Hays County TX Low Water Crossing System\AutoCAD\AS BUILT\FLASHERS\50024 - POST ROAD AT BLANCO RIVER\50024 - POST ROAD AT BLANCO RIVER.dwg



Designed:	EEC
Drawn:	EEC
Checked:	MLR
Edt:	2-9-2018

Title:	50024 - POST ROAD AT BLANCO RIVER CONDUIT DETAIL #1
Filepath:	P:\A637 Hays County TX Low Water Crossing System\AutoCAD\AS BUILT\FLASHERS\50024 - POST ROAD AT BLANCO RIVER\50024 - POST ROAD AT BLANCO RIVER.dwg

Scale:	NOT TO SCALE
Copy:	AS BUILT

Project No:	A637
Drawing:	5



Designed:	EEC
Drawn:	EEC
Checked:	MLR
Edit:	2-9-2018

Title:	50024 - POST ROAD AT BLANCO RIVER CONDUIT DETAIL #2
Filepath:	P:\A637 Hays County TX Low Water Crossing System\AutoCAD\AS BUILT\FLASHERS\50024 - POST ROAD AT BLANCO RIVER\50024 - POST ROAD AT BLANCO RIVER.dwg

Scale:	NOT TO SCALE
Copy:	AS BUILT

Project No:	A637
Drawing:	6



Designed:	EEC
Drawn:	EEC
Checked:	MLR
Edit:	2-9-2018

Title:	50024 - POST ROAD AT BLANCO RIVER CONDUIT DETAIL #3
Filepath:	P:\A637 Hays County TX Low Water Crossing System\AutoCAD\AS BUILT\FLASHERS\50024 - POST ROAD AT BLANCO RIVER\50024 - POST ROAD AT BLANCO RIVER.dwg

Scale:	NOT TO SCALE
Copy:	AS BUILT

Project No:	A637
Drawing:	7

