



Designed:	EEC
Drawn:	EEC
Checked:	MLR
Edt:	1-9-2018

Title:	50026 - CR 1492 AT BLANCO RIVER SITE AERIAL VIEW
Filepath:	P:\A637 Hays County TX Low Water Crossing System\AutoCADAS BUILT\FLASHERS\50026 - CR 1492 AT BLANCO RIVER\50026 - CR 1492 at Blanco River.dwg

Scale:	NOT TO SCALE
Copy:	AS BUILT

Project No:	A637
Drawing:	1




Designed:	EEC
Drawn:	EEC
Checked:	MLR
Edit:	1-9-2018

Title:	50026 - CR 1492 AT BLANCO RIVER MASTER AERIAL VIEW
Filepath:	P:\A637 Hays County TX Low Water Crossing System\AutoCAD\AS BUILT\FLASHERS\50026 - CR 1492 AT BLANCO RIVER\50026 - CR 1492 at Blanco River.dwg

Scale:	NOT TO SCALE
Copy:	AS BUILT

Project No:	A637
Drawing:	2

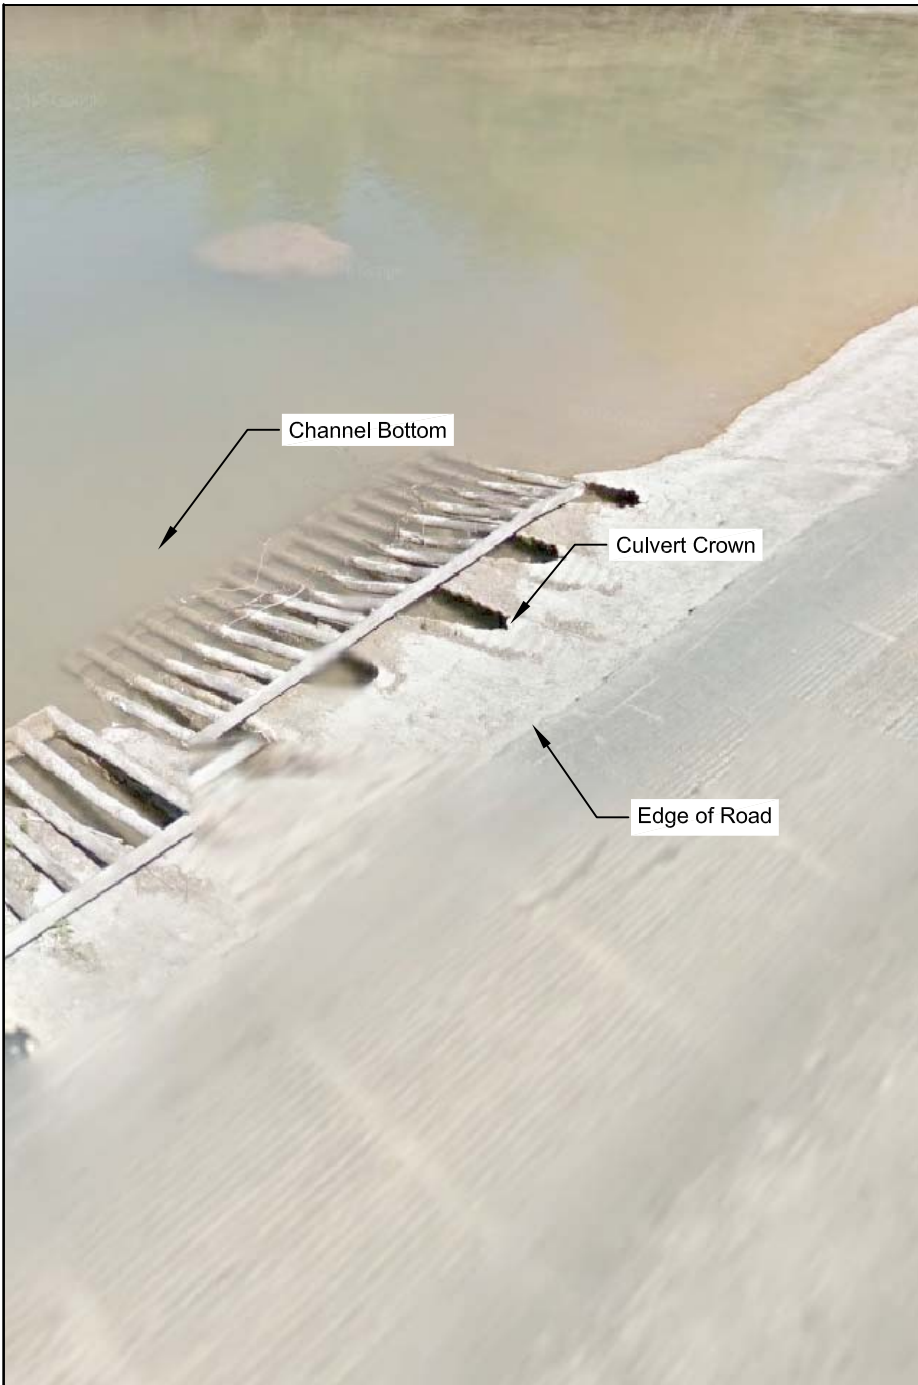

ID	STATION NAME	DESCRIPTION	ROD (FT)	DEPTH (FT)	CALCULATED TRIGGER ELEVATION	PROGRAMMED TRIGGER ELEVATION
50026	CR 1492 at Blanco River	Channel Bottom	8.71	-0.04	2.05	1.95
		Stop Bolt	8.67	0.00		
		Intake Line	7.83	0.84		
		Culvert Crown	6.72	1.95		
		Top of Riser	6.54	2.13		
		Edge of Road	6.62	2.05		




Designed:	EEC
Drawn:	EEC
Checked:	MLR
Edit:	1-9-2018

Title:	50026 - CR 1492 AT BLANCO RIVER SURVEY & RISER DETAIL
Filepath:	P:\A637 Hays County TX Low Water Crossing System\AutoCAD\AS BUILT\FLASHERS\50026 - CR 1492 AT BLANCO RIVER\50026 - CR 1492 at Blanco River.dwg

Scale:	NOT TO SCALE
Copy:	AS BUILT

Project No:	A637
Drawing:	3

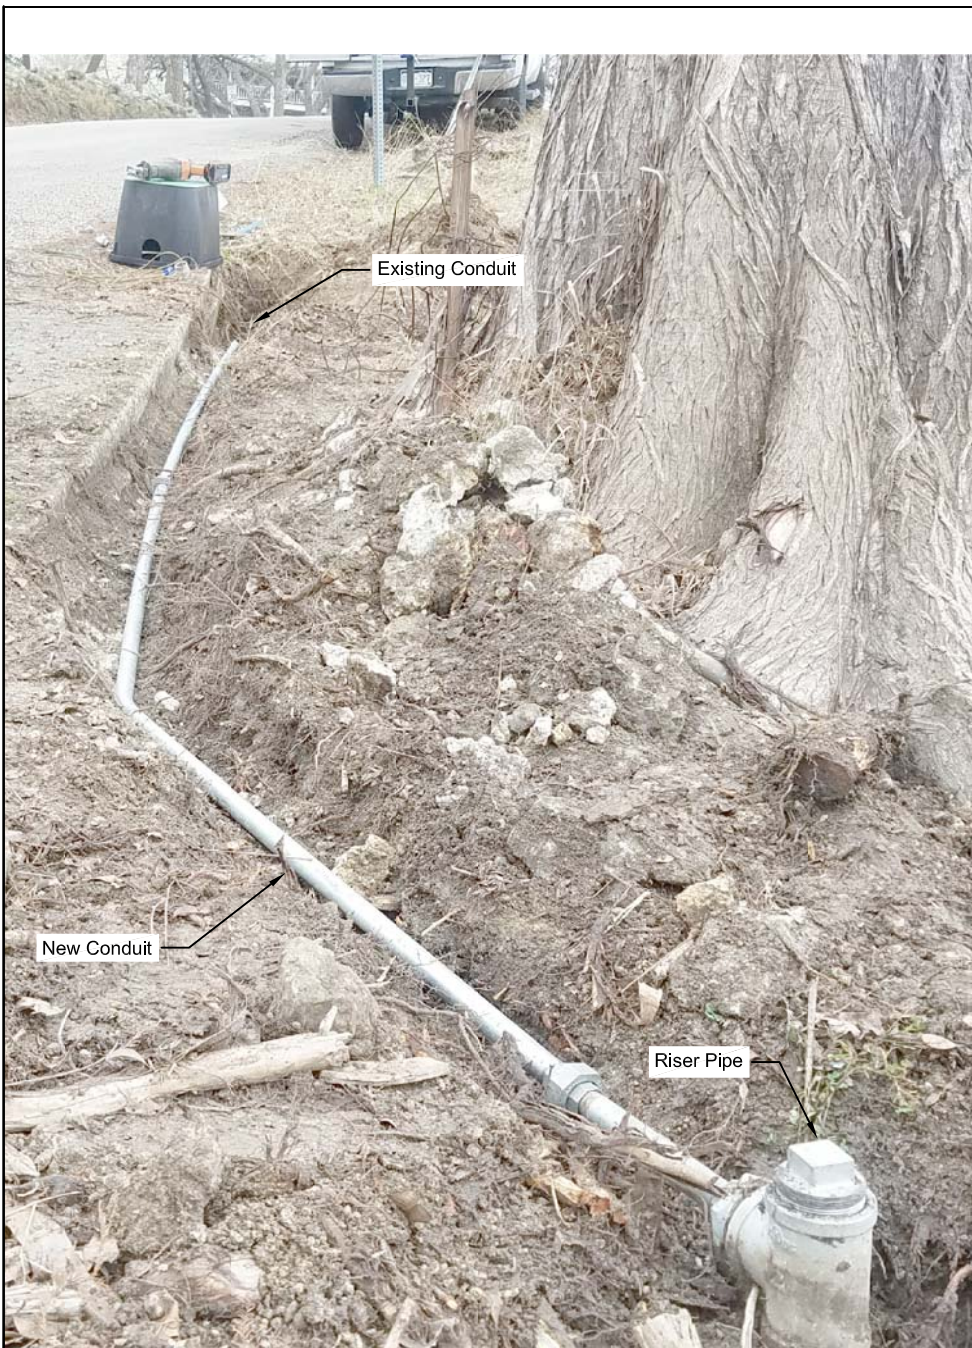


Designed:	EEC
Drawn:	EEC
Checked:	MLR
Edit:	1-9-2018

Title:	50026 - CR 1492 AT BLANCO RIVER CONDUIT DETAIL
Filepath:	P:\A637 Hays County TX Low Water Crossing System\AutoCADAS BUILT\FLASHERS\50026 - CR 1492 AT BLANCO RIVER\50026 - CR 1492 at Blanco River.dwg

Scale:	NOT TO SCALE
Copy:	AS BUILT

Project No:	A637
Drawing:	4


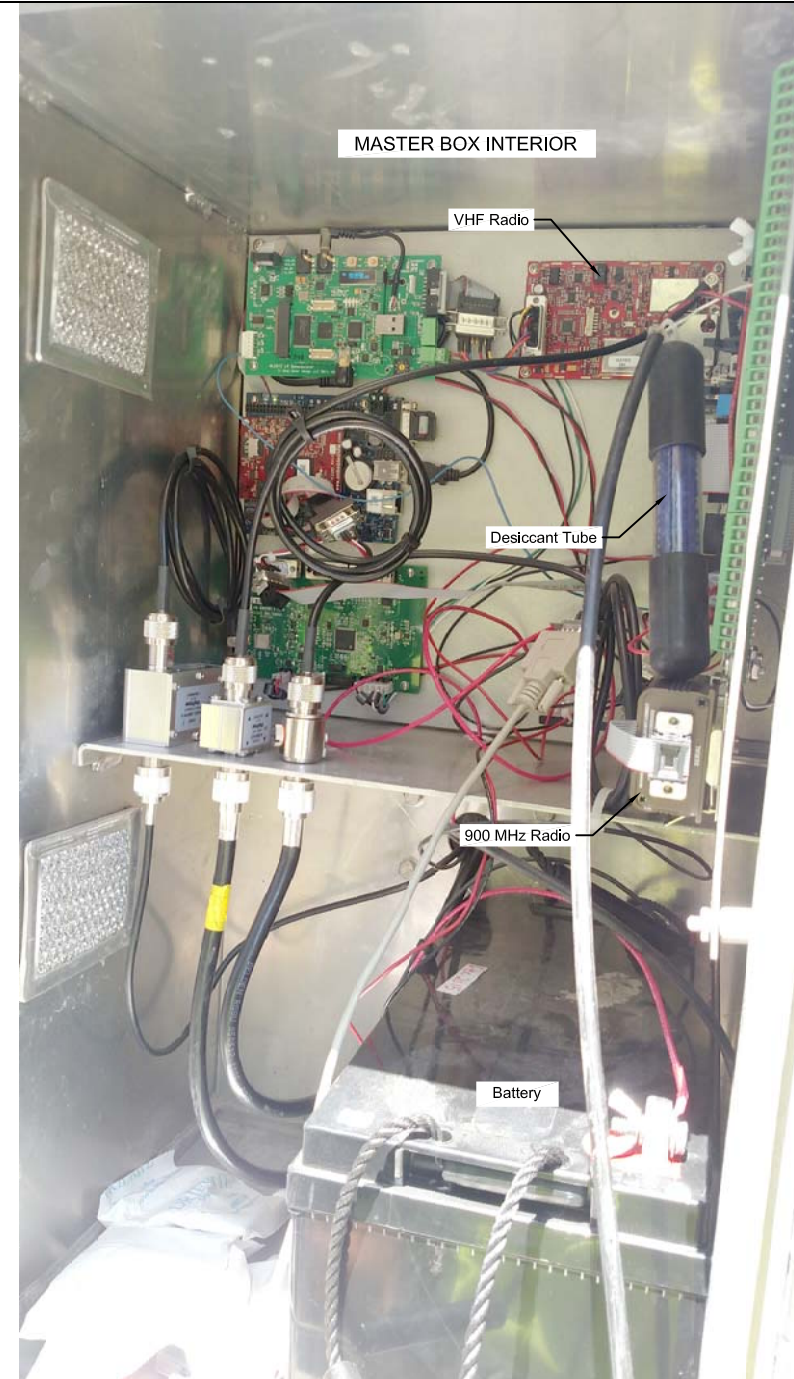





Designed:	EEC
Drawn:	EEC
Checked:	MLR
Edt:	1-9-2018

Title:	50026 - CR 1492 AT BLANCO RIVER MASTER DETAILS
Filepath:	P:\A637 Hays County TX Low Water Crossing System\AutoCADAS BUILT\FLASHERS\50026 - CR 1492 AT BLANCO RIVER\50026 - CR 1492 at Blanco River.dwg

Scale:	NOT TO SCALE
Copy:	AS BUILT

Project No:	A637
Drawing:	5

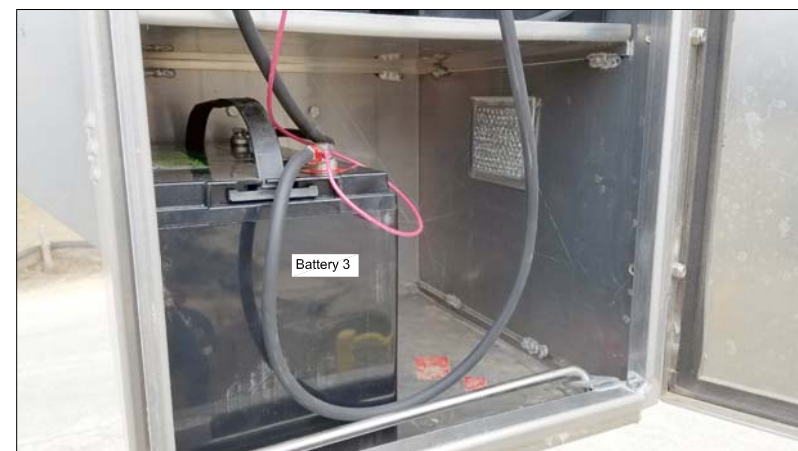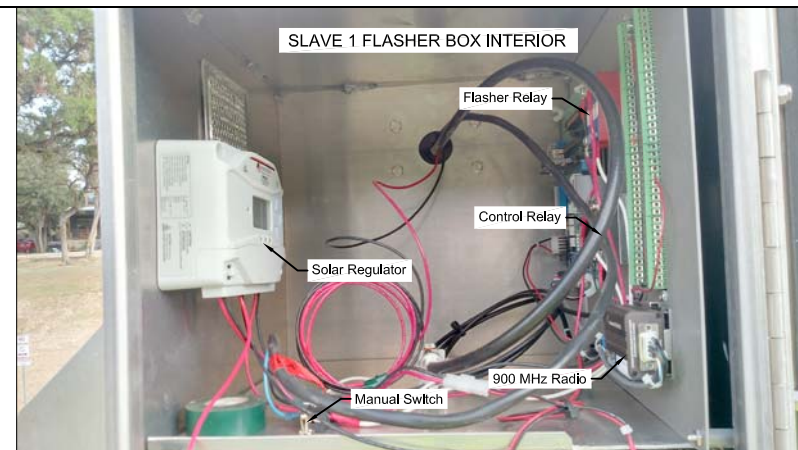

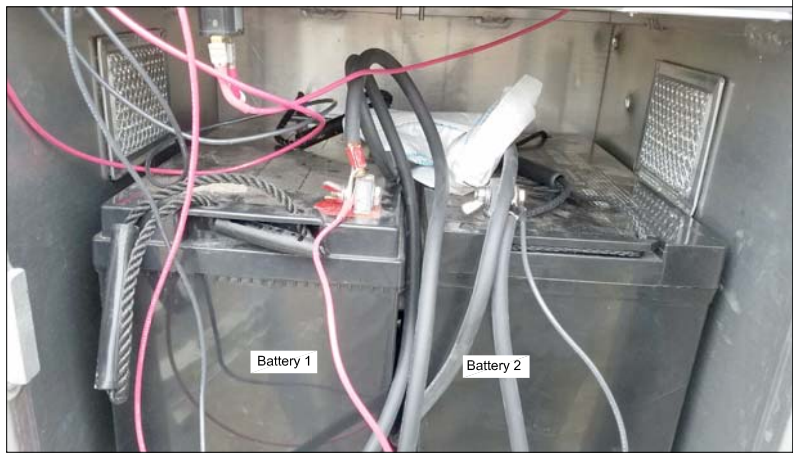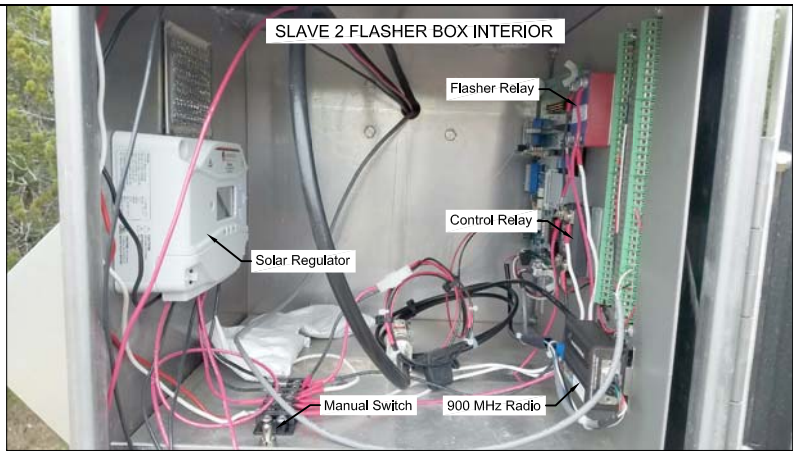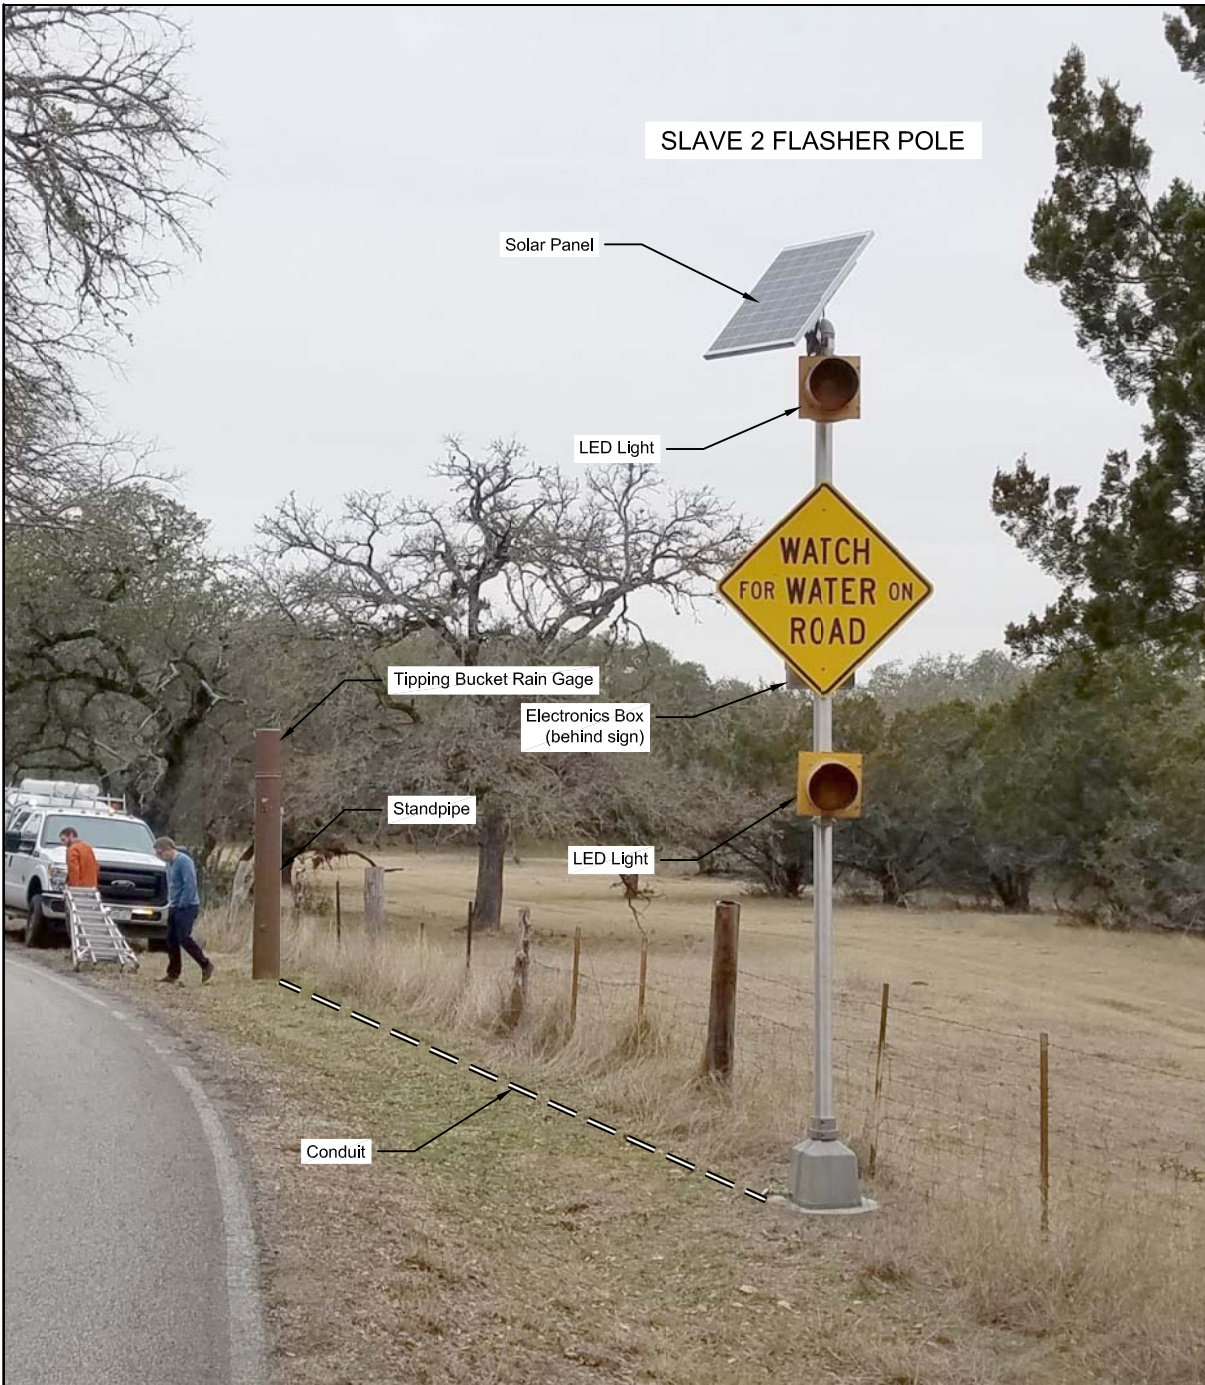

Designed:	EEC
Drawn:	EEC
Checked:	MLR
Edit:	1-9-2018

Title:	50026 - CR 1492 AT BLANCO RIVER SLAVE 2 FLASHER DETAIL
Filepath:	P:\A637 Hays County TX Low Water Crossing System\AutoCADAS BUILT\FLASHERS\50026 - CR 1492 AT BLANCO RIVER\50026 - CR 1492 at Blanco River.dwg

Scale:	NOT TO SCALE
Copy:	AS BUILT

Project No:	A637
Drawing:	7