



Designed:	EEC
Drawn:	EEC
Checked:	MLR
Edit:	1-31-2018

Title:	50027 - LITTLE ARKANSAS RD AT BLANCO RIVER SITE AERIAL VIEW
Filepath:	P:\A637 Hays County TX Low Water Crossing System\AutoCADAS BUILT\FLASHERS\50027 - LITTLE ARKANSAS RD AT BLANCO RIVER\50027 - LITTLE ARKANSAS.dwg

Scale:	NOT TO SCALE
Copy:	AS BUILT

Project No:	A637
Drawing:	1




Designed:	EEC
Drawn:	EEC
Checked:	MLR
Edit:	1-31-2018

Title:	50027 - LITTLE ARKANSAS RD AT BLANCO RIVER MASTER AERIAL VIEW
Filepath:	P:\A637 Hays County TX Low Water Crossing System\AutoCADAS BUILT\FLASHERS\50027 - LITTLE ARKANSAS RD AT BLANCO RIVER\50027 - LITTLE ARKANSAS.dwg

Scale:	NOT TO SCALE
Copy:	AS BUILT

Project No:	A637
Drawing:	2

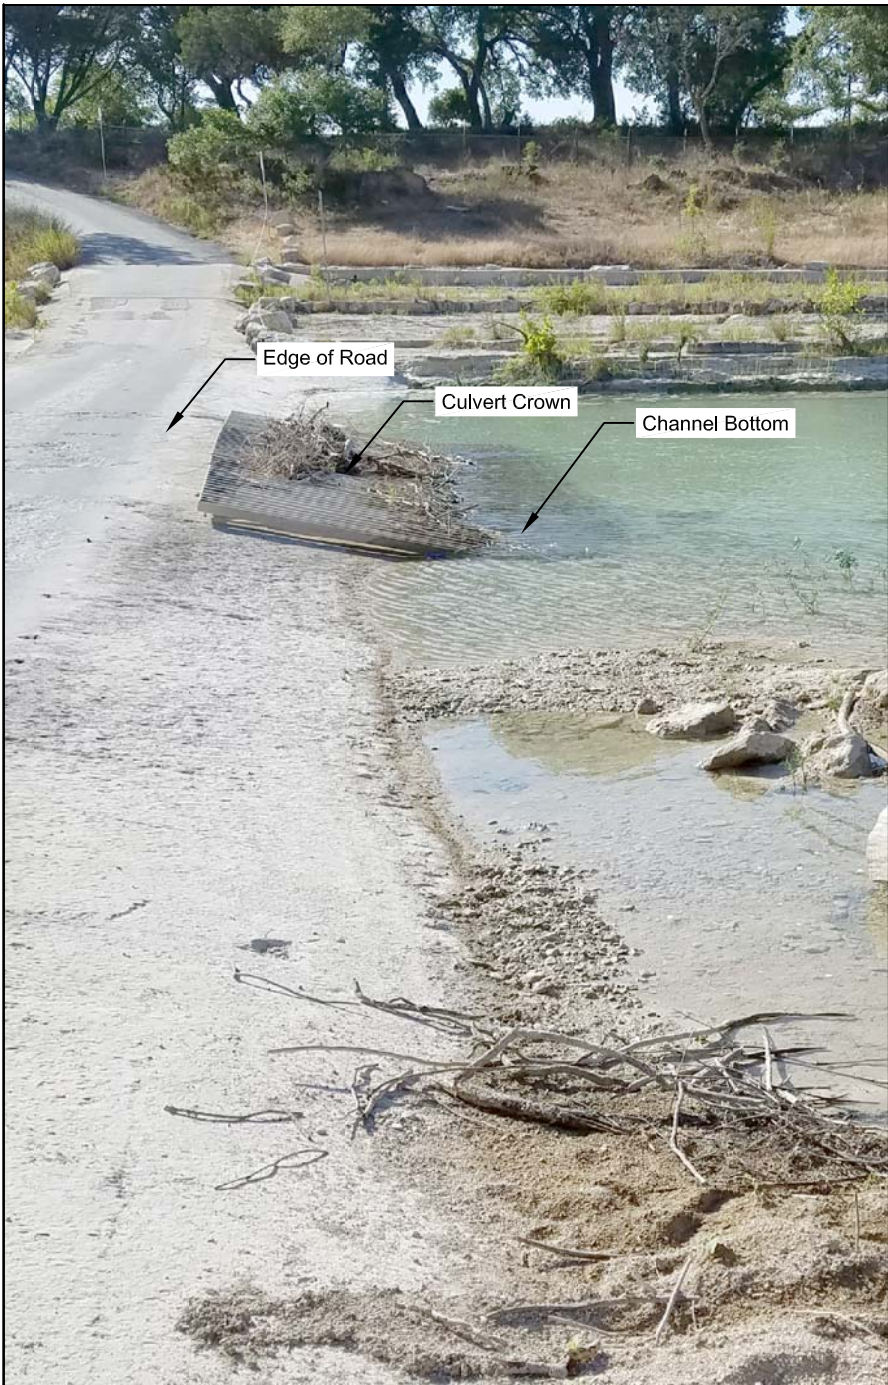

ID	STATION NAME	DESCRIPTION	ROD (FT)	DEPTH (FT)	CALCULATED TRIGGER ELEVATION	PROGRAMMED TRIGGER ELEVATION
50027	Little Arkansas Rd (CR 174) at Blanco River	Channel Bottom	10.04	-0.62	2.11	2.01
		Stop Bolt	9.42	0.00		
		Intake Line	8.91	0.51		
		Top of Riser	7.38	2.04		
		Culvert Crown	8.24	1.18		
		Edge of Road	7.31	2.11		



Designed:	EEC
Drawn:	EEC
Checked:	MLR
Edt:	1-31-2018

Title:	50027 - LITTLE ARKANSAS RD AT BLANCO RIVER SURVEY & CONDUIT DETAIL
	Filepath: P:\A637 Hays County TX Low Water Crossing System\AutoCADAS BUILT\FLASHERS\50027 - LITTLE ARKANSAS RD AT BLANCO RIVER\50027 - LITTLE ARKANSAS.dwg

Scale:	NOT TO SCALE
Copy:	AS BUILT

Project No:	A637
Drawing:	3

ID	STATION NAME	DESCRIPTION	ROD (FT)	DEPTH (FT)	CALCULATED TRIGGER ELEVATION	PROGRAMMED TRIGGER ELEVATION
50027	Little Arkansas Rd (CR 174) at Blanco River	Channel Bottom	10.04	-0.62	2.11	2.01
		Stop Bolt	9.42	0.00		
		Intake Line	8.91	0.51		
		Top of Riser	7.38	2.04		
		Culvert Crown	8.24	1.18		
		Edge of Road	7.31	2.11		




Designed:	EEC
Drawn:	EEC
Checked:	MLR
Edt:	1-31-2018

Title:	50027 - LITTLE ARKANSAS RD AT BLANCO RIVER RISER DETAIL
Filepath:	P:\A637 Hays County TX Low Water Crossing System\AutoCADAS BUILT\FLASHERS\50027 - LITTLE ARKANSAS RD AT BLANCO RIVER\50027 - LITTLE ARKANSAS.dwg

Scale:	NOT TO SCALE
Copy:	AS BUILT

Project No:	A637
Drawing:	4

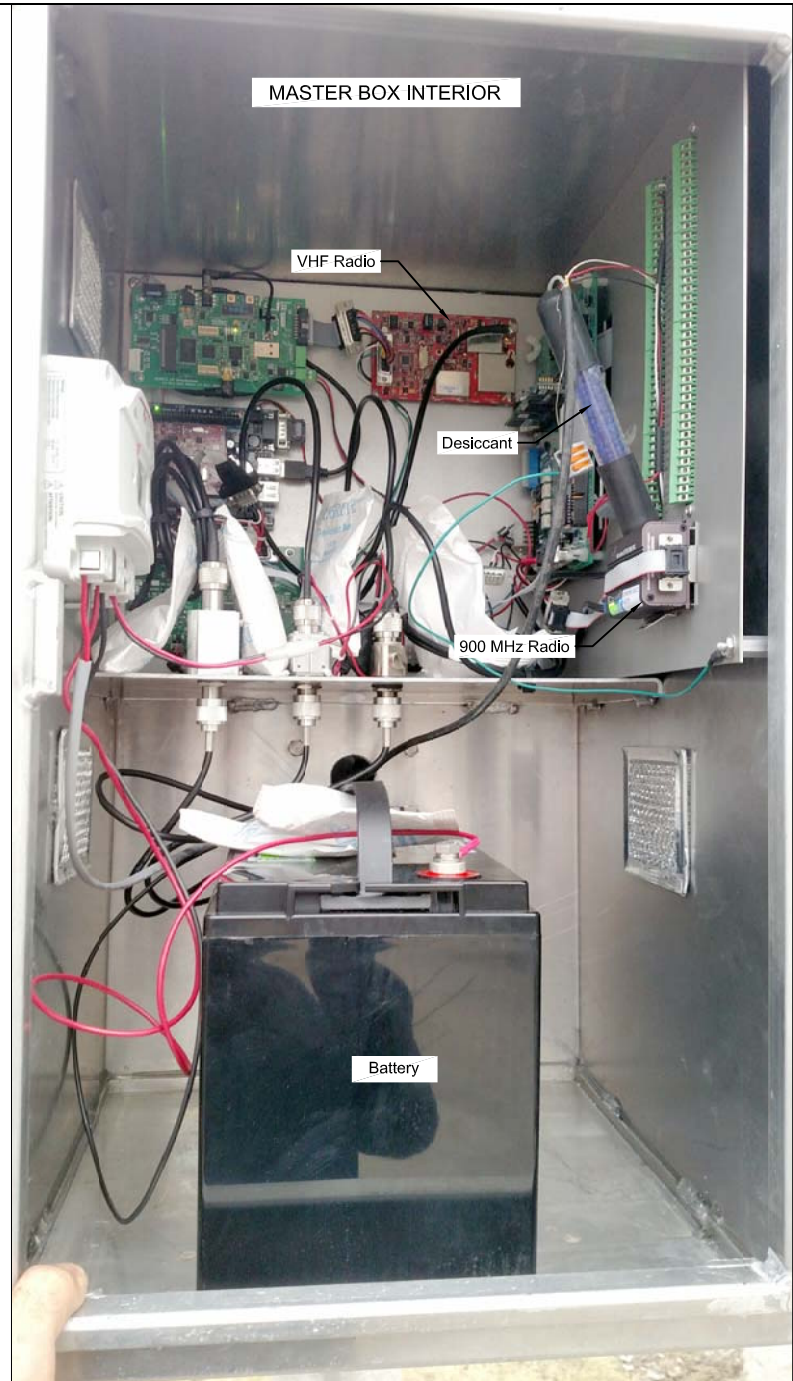

Designed:	EEC
Drawn:	EEC
Checked:	MLR
Edt:	1-31-2018

Title:	50027 - LITTLE ARKANSAS RD AT BLANCO RIVER MASTER DETAILS
Filepath:	P:\A637 Hays County TX Low Water Crossing System\AutoCADAS BUILT\FLASHERS\50027 - LITTLE ARKANSAS RD AT BLANCO RIVER\50027 - LITTLE ARKANSAS.dwg

Scale:	NOT TO SCALE
Copy:	AS BUILT

Project No:	A637
Drawing:	5

