



Designed:	EEC
Drawn:	EEC
Checked:	MLR
Edit:	1-9-2018

Title:	50028 - JACOBS WELL RD AT CYPRESS CREEK SITE AERIAL VIEW
Filepath:	P:\A637 Hays County TX Low Water Crossing System\AutoCADAS BUILT\FLASHERS\50028 - JACOBS WELL RD AT CYPRESS CREEK\50028 - JACOBS WELL RD.dwg

Scale:	NOT TO SCALE
Copy:	AS BUILT

Project No:	A637
Drawing:	1




Designed: EEC
 Drawn: EEC
 Checked: MLR
 Edit: 1-9-2018

Title: 50028 - JACOBS WELL RD AT CYPRESS CREEK MASTER AERIAL VIEW
 Filepath: P:\A637 Hays County TX Low Water Crossing System\AutoCAD\AS BUILT\FLASHERS\50028 - JACOBS WELL RD AT CYPRESS CREEK\50028 - JACOBS WELL RD.dwg

Scale: NOT TO SCALE
 Copy: AS BUILT

Project No: A637
 Drawing: 2

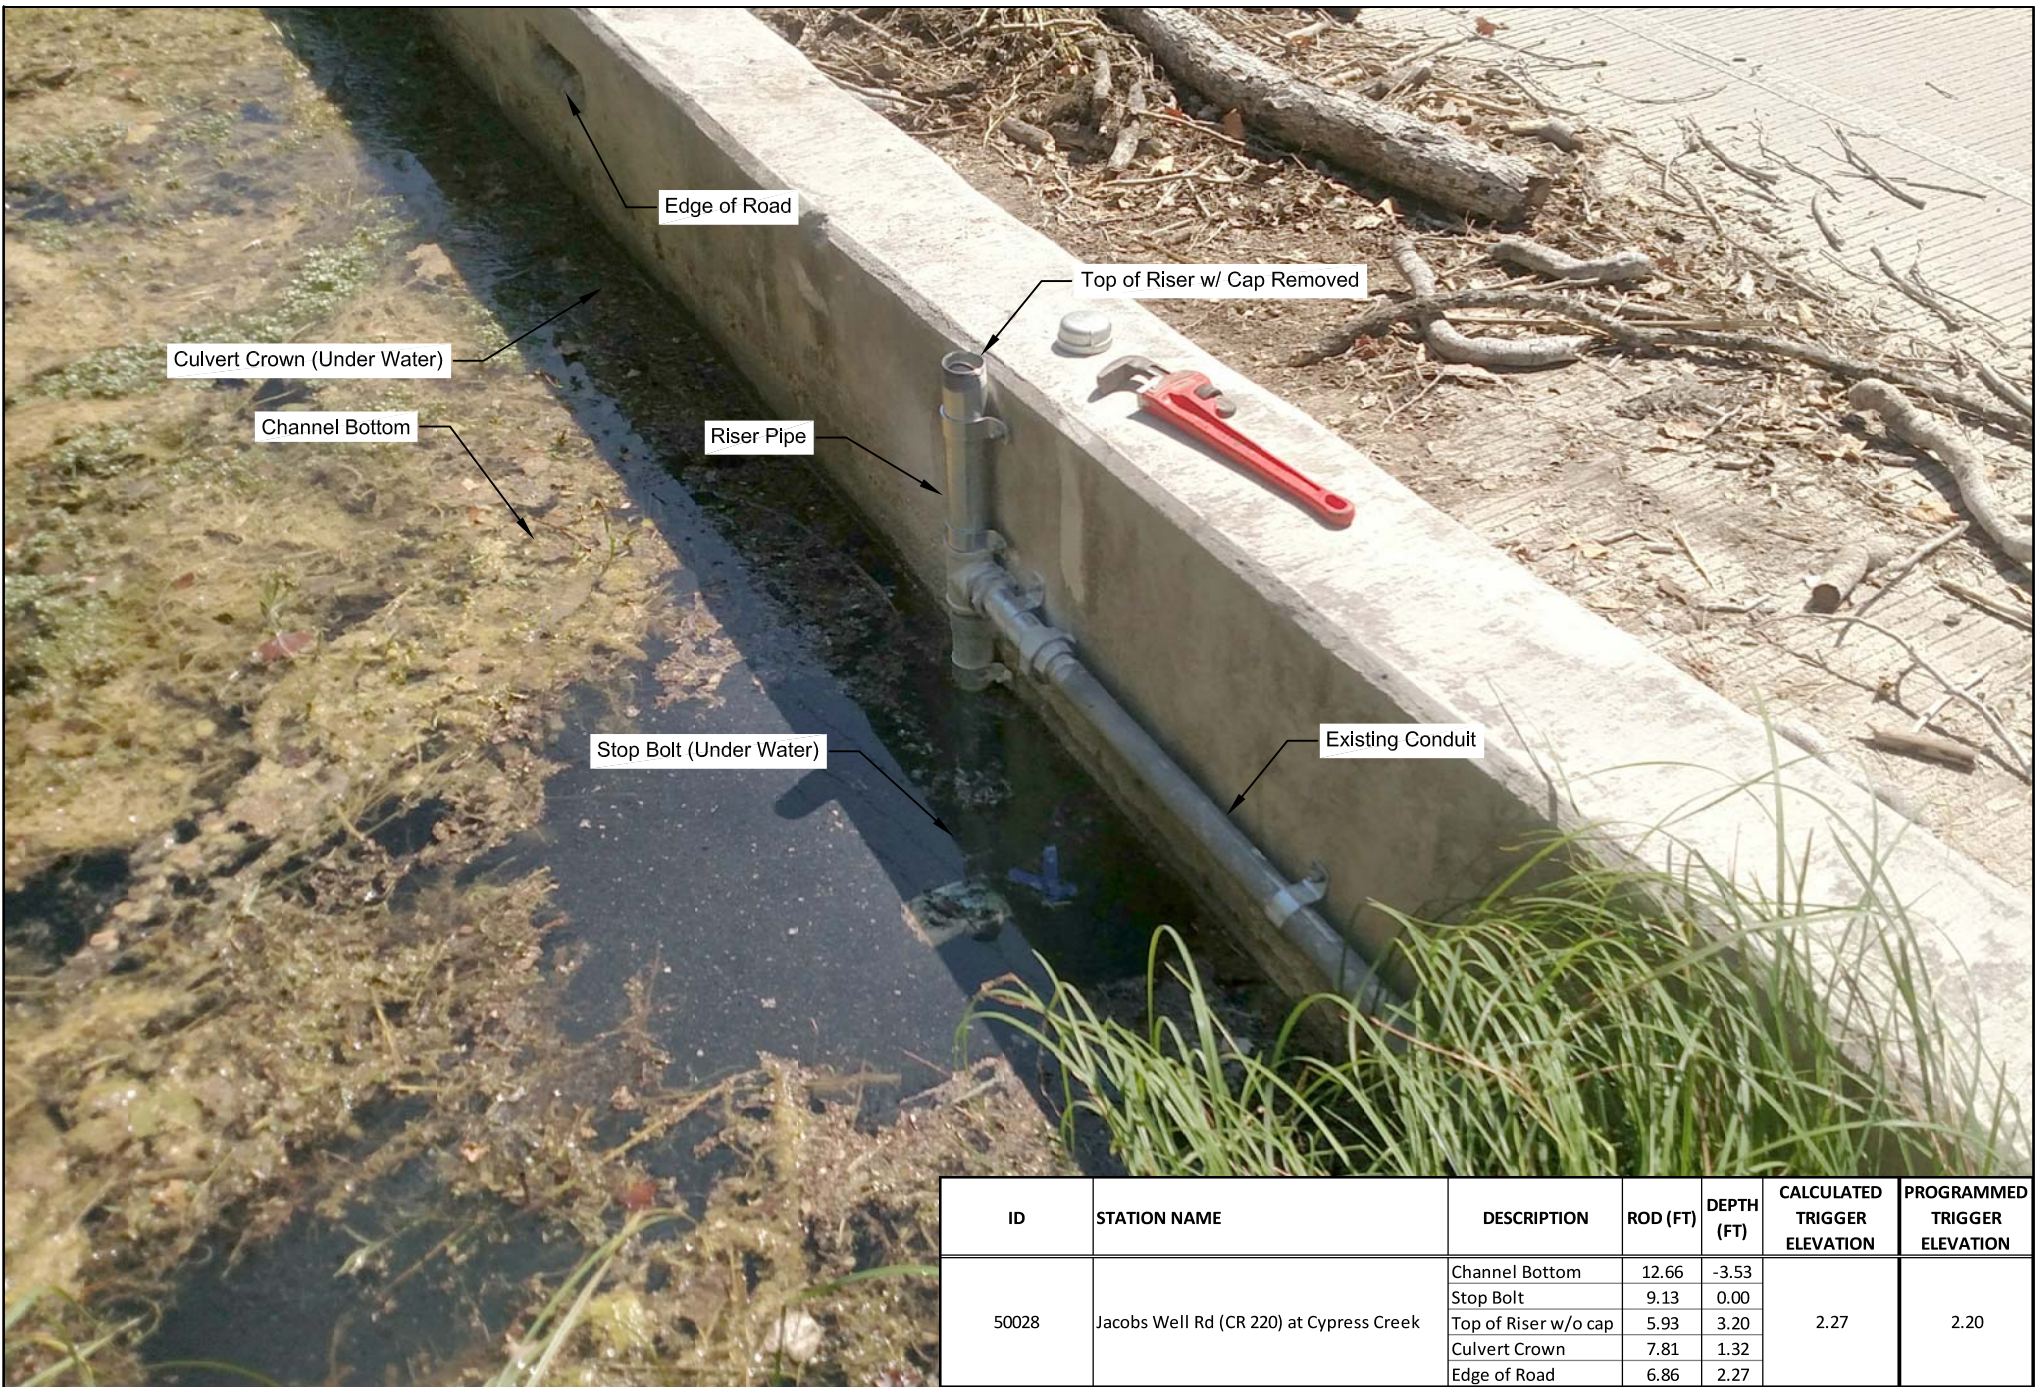

ID	STATION NAME	DESCRIPTION	ROD (FT)	DEPTH (FT)	CALCULATED TRIGGER ELEVATION	PROGRAMMED TRIGGER ELEVATION
50028	Jacobs Well Rd (CR 220) at Cypress Creek	Channel Bottom	12.66	-3.53	2.27	2.20
		Stop Bolt	9.13	0.00		
		Top of Riser w/o cap	5.93	3.20		
		Culvert Crown	7.81	1.32		
		Edge of Road	6.86	2.27		




Designed: EEC
 Drawn: EEC
 Checked: MLR
 Edit: 1-9-2018

Title: 50028 - JACOBS WELL RD AT CYPRESS CREEK SURVEY & RISER DETAIL
 Filepath: P:\A637 Hays County TX Low Water Crossing System\AutoCADAS BUILT\FLASHERS\50028 - JACOBS WELL RD AT CYPRESS CREEK\50028 - JACOBS WELL RD.dwg

Scale: NOT TO SCALE
 Copy: AS BUILT

Project No: A637
 Drawing: 3

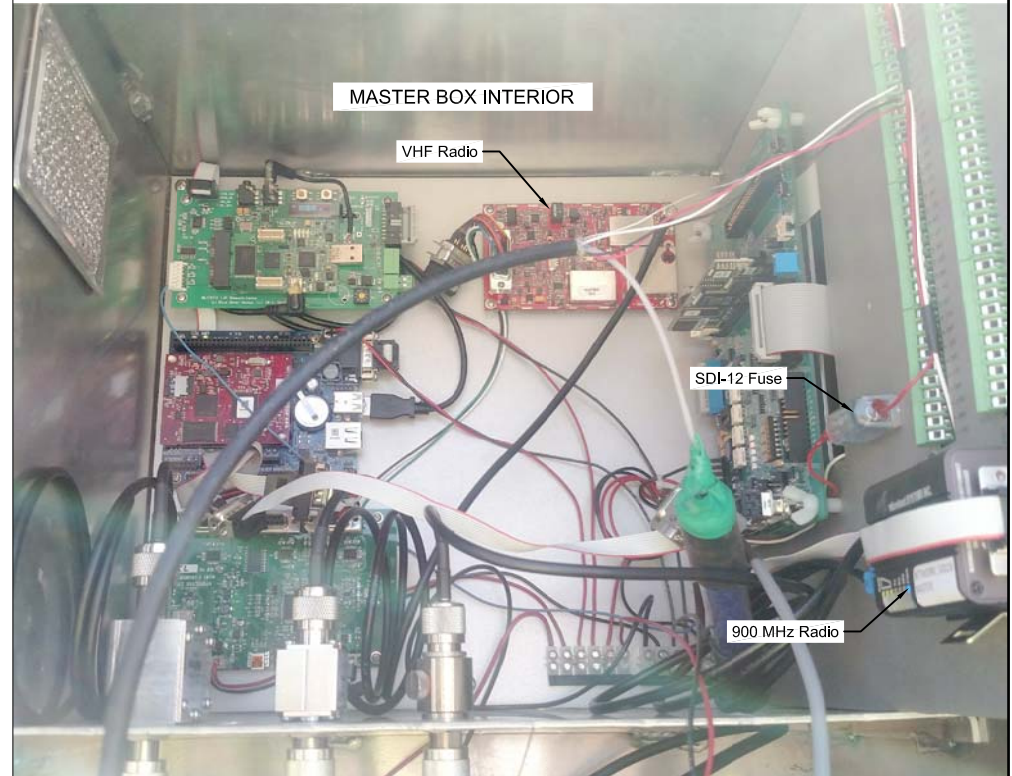

Designed:	EEC
Drawn:	EEC
Checked:	MLR
Edt:	1-9-2018

Title:	50028 - JACOBS WELL RD AT CYPRESS CREEK MASTER DETAILS
Filepath:	P:\A637 Hays County TX Low Water Crossing System\AutoCAD\AS BUILT\FLASHERS\50028 - JACOBS WELL RD AT CYPRESS CREEK\50028 - JACOBS WELL RD.dwg

Scale:	NOT TO SCALE
Copy:	AS BUILT

Project No:	A637
Drawing:	4

