



Designed: EEC
 Drawn: EEC
 Checked: MLR
 Edit: 11-14-2017

Title: 50029 - ROHDE ROAD AT BRUSHY CREEK
 SITE AERIAL VIEW
 Filepath: P:\A637 Hays County TX Low Water Crossing System\AutoCAD\AS BUILT\FLASHERS\50029 - ROHDE RD AT BRUSHY CREEK\ Rohde Rd.dwg

Scale: NOT TO SCALE
 Copy: AS BUILT

Project No: A637
 Drawing: 1



Designed:	EEC
Drawn:	EEC
Checked:	MLR
Edit:	11-14-2017

Title:	50029 - ROHDE ROAD AT BRUSHY CREEK MASTER & RISER AERIAL VIEW
Filepath:	

Scale:	NOT TO SCALE
Copy:	AS BUILT

Project No:	A637
Drawing:	2



Designed:	EEC
Drawn:	EEC
Checked:	MLR
Edit:	11-14-2017

Title:	50029 - ROHDE ROAD AT BRUSHY CREEK RISER PIPE & CONDUIT DETAILS
Filepath:	P:\A637 Hays County TX Low Water Crossing System\AutoCAD\AS BUILT\FLASHERS\50029 - ROHDE RD AT BRUSHY CREEK\ Rohde Rd.dwg

Scale:	NOT TO SCALE
Copy:	AS BUILT

Project No:	A637
Drawing:	3

ID	STATION NAME	DESCRIPTION	ROD (FT)	DEPTH (FT)	CALCULATED TRIGGER ELEVATION	PROGRAMMED TRIGGER ELEVATION
50029	Rohde Rd (CR 126) at Brushy Creek	Channel Bottom	9.82	-0.89	5.05	5.00
		Stop Bolt	8.93	0.00		
		Top of Riser	6.84	2.09		
		Culvert Crown	6.26	2.67		
		Edge of Road	3.88	5.05		





Designed:	EEC
Drawn:	EEC
Checked:	MLR
Edt:	11-14-2017

Title:	50029 - ROHDE ROAD AT BRUSHY CREEK RISER PIPE & SURVEY DETAILS
Filepath:	P:\A637 Hays County TX Low Water Crossing System\AutoCAD\AS BUILT\FLASHERS\50029 - ROHDE RD AT BRUSHY CREEK\ Rohde Rd.dwg

Scale:	NOT TO SCALE
Copy:	AS BUILT

Project No:	A637
Drawing:	4

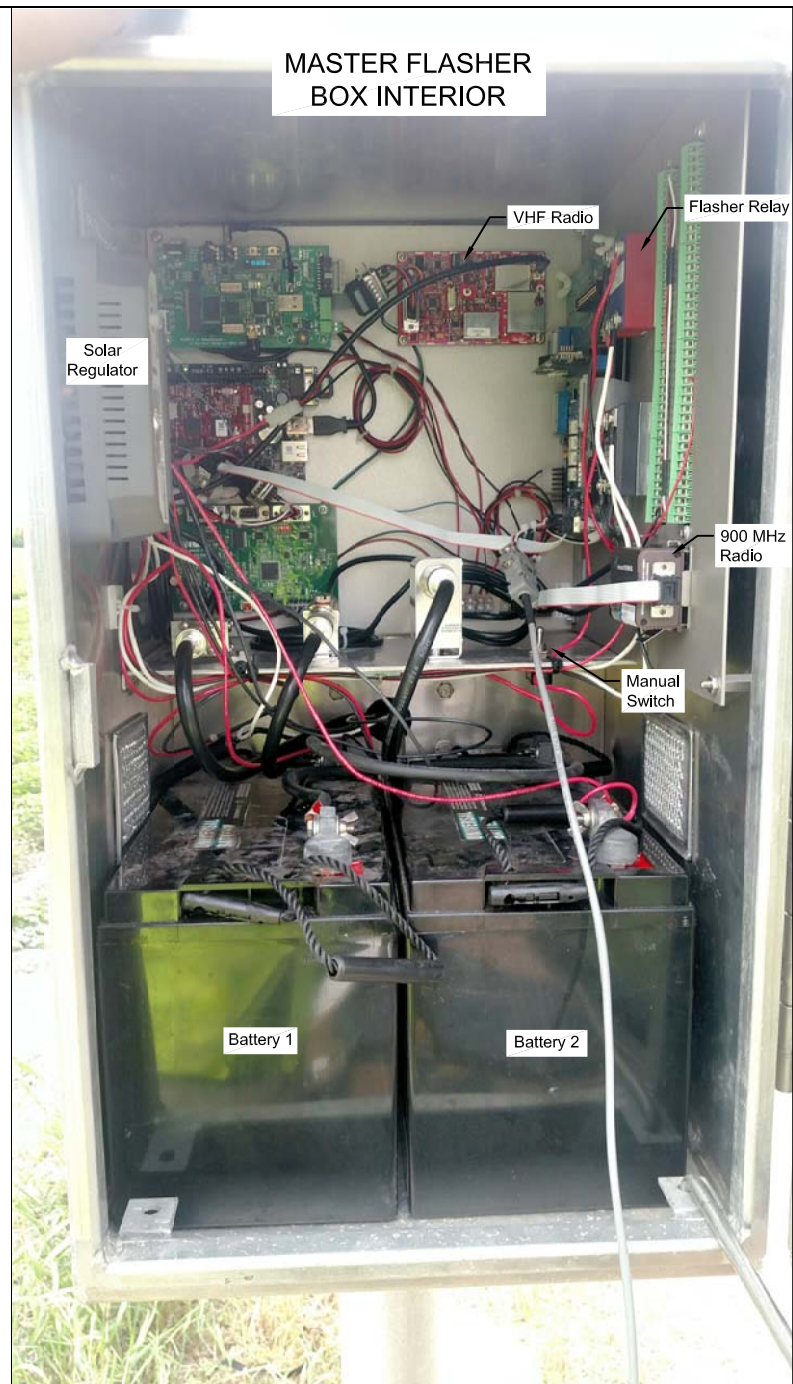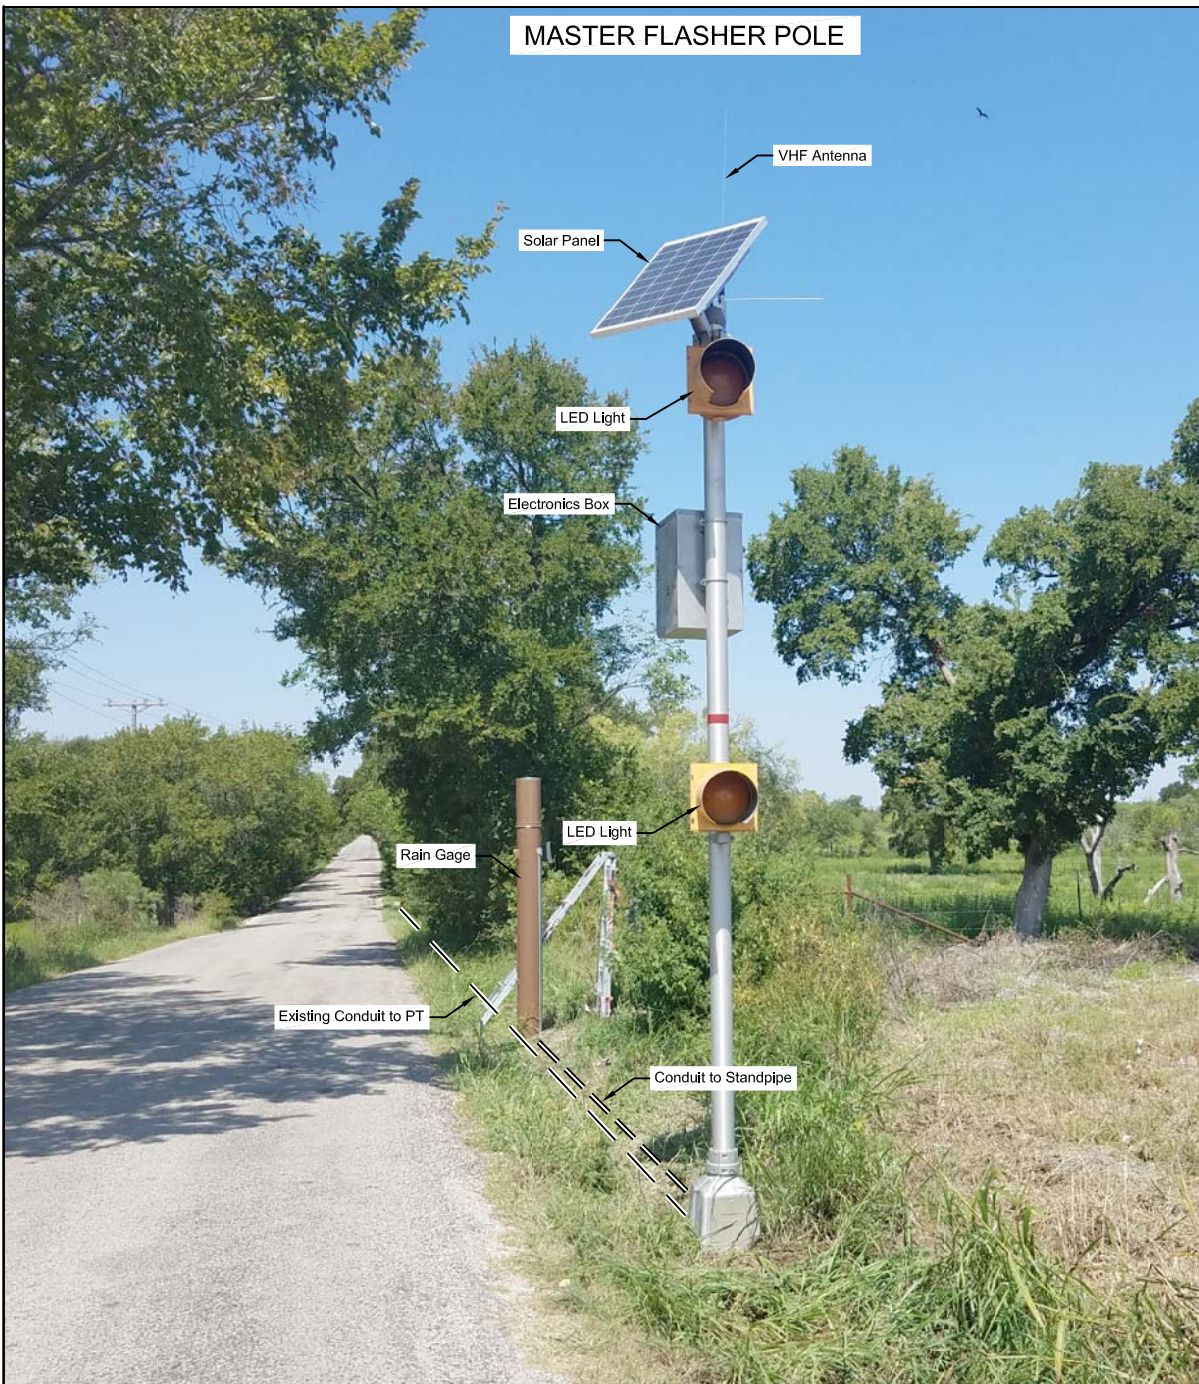

SLAVE 1 FLASHER POLE



SLAVE 1 FLASHER BOX INTERIOR

