



Designed:	EEC
Drawn:	EEC
Checked:	MLR
Edit:	12-4-2017

Title:	50030 - WINDY HILL RD AT ANDREWS BRANCH SITE AERIAL VIEW
	Filepath: P:\A637 Hays County TX Low Water Crossing System\AutoCADAS BUILT\FLASHERS\50030 - WINDY HILL RD\50030 - WINDY HILL RD.dwg

Scale:	NOT TO SCALE
Copy:	AS BUILT

Project No:	A637
Drawing:	1



HILL RD

205

Master

Slave 1 Flasher

Existing Conduit

Riser Pipe

Windy Hill Rd



Designed:	EEC
Drawn:	EEC
Checked:	MLR
Edit:	12-4-2017

Title:	50030 - WINDY HILL RD AT ANDREWS BRANCH MASTER AERIAL VIEW
	Filepath: P:\A637 Hays County TX Low Water Crossing System\AutoCAD\AS BUILT\FLASHERS\50030 - WINDY HILL RD\50030 - WINDY HILL RD.dwg

Scale:	NOT TO SCALE
Copy:	AS BUILT

Project No:	A637
Drawing:	2




ID	STATION NAME	DESCRIPTION	ROD (FT)	DEPTH (FT)	CALCULATED TRIGGER ELEVATION	PROGRAMMED TRIGGER ELEVATION
50030	Windy Hill Rd (CR 131) at Andrews Branch	Channel Bottom	13.49	-0.61	8.08	7.98
		Stop Bolt	12.88	0.00		
		Top of Riser	8.84	4.04		
		Culvert Crown	8.52	4.36		
		Edge of Road	4.80	8.08		

Scale:	NOT TO SCALE	Project No:	A637
Copy:	AS BUILT	Drawing:	3

	Designed:	EEC	Title: 50030 - WINDY HILL RD AT ANDREWS BRANCH SURVEY & RISER DETAIL	Scale: NOT TO SCALE	Project No: A637
	Drawn:	EEC			
	Checked:	MLR			
	Edit: 12-4-2017	Filepath: P:\A637 Hays County TX Low Water Crossing System\AutoCADAS BUILT\FLASHERS\50030 - WINDY HILL RD\50030 - WINDY HILL RD.dwg			



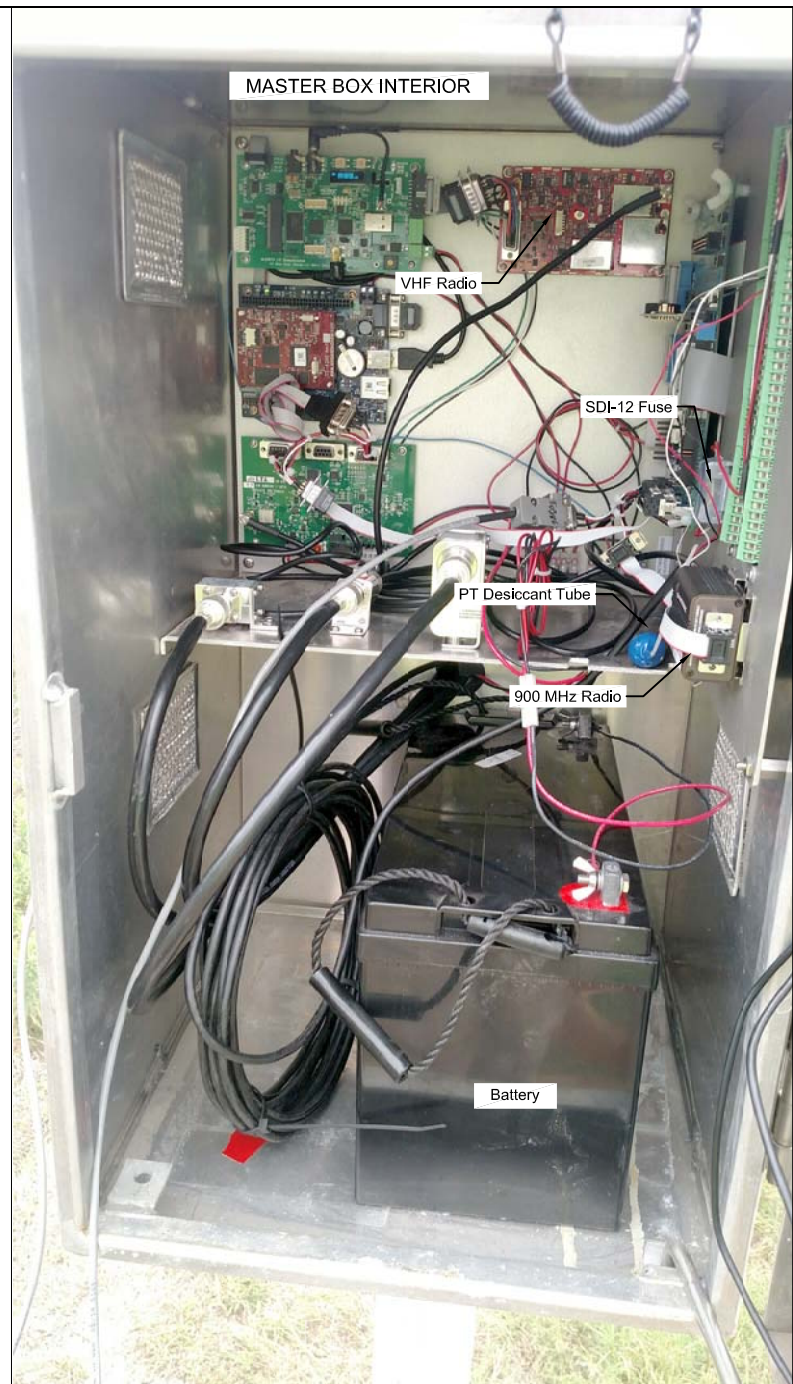

Designed:	EEC
Drawn:	EEC
Checked:	MLR
Edit:	12-4-2017

Title:	50030 - WINDY HILL RD AT ANDREWS BRANCH MASTER DETAILS
Filepath:	P:\A637 Hays County TX Low Water Crossing System\AutoCADAS BUILT\FLASHERS\50030 - WINDY HILL RD\50030 - WINDY HILL RD.dwg

Scale:	NOT TO SCALE
Copy:	AS BUILT

Project No:	A637
Drawing:	5

SLAVE 1 FLASHER POLE



SLAVE 1 FLASHER BOX INTERIOR




Designed:	EEC
Drawn:	EEC
Checked:	MLR
Edt:	12-4-2017

Title:	50030 - WINDY HILL RD AT ANDREWS BRANCH SLAVE 1 FLASHER DETAIL
	Filepath: P:\A637 Hays County TX Low Water Crossing System\AutoCADAS BUILT\FLASHERS\50030 - WINDY HILL RD\50030 - WINDY HILL RD.dwg

Scale:	NOT TO SCALE
Copy:	AS BUILT

Project No:	A637
Drawing:	6

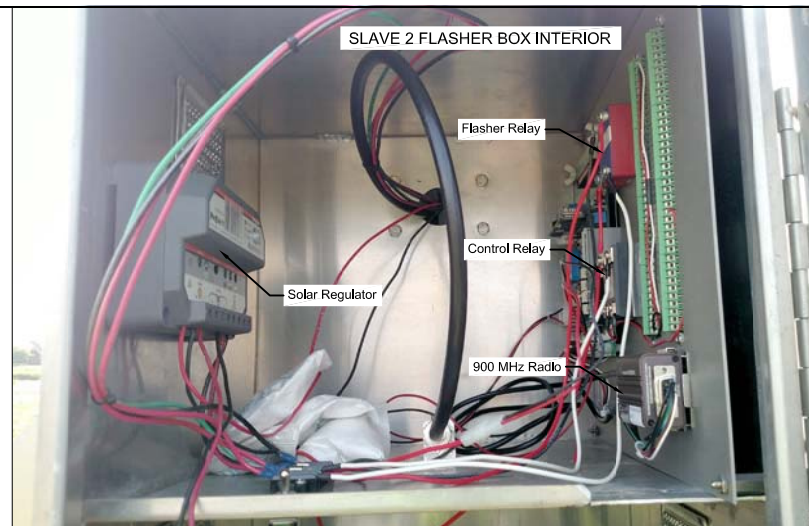

Designed:	EEC
Drawn:	EEC
Checked:	MLR
Edt:	12-4-2017

Title:	50030 - WINDY HILL RD AT ANDREWS BRANCH SLAVE 2 FLASHER DETAIL
Filepath:	P:\A637 Hays County TX Low Water Crossing System\AutoCADAS BUILT\FLASHERS\50030 - WINDY HILL RD\50030 - WINDY HILL RD.dwg

Scale:	NOT TO SCALE
Copy:	AS BUILT

Project No:	A637
Drawing:	7