



Designed:	EEC
Drawn:	EEC
Checked:	MLR
Edt:	12-4-2017

Title:	50031 - CHAPARRAL RD AT LITTLE BEAR CREEK SITE AERIAL VIEW
	Filepath: P:\A637 Hays County TX Low Water Crossing System\AutoCADAS BUILT\FLASHERS\50031 - CHAPARRAL RD\50031 - CHAPARRAL RD.dwg

Scale:	NOT TO SCALE
Copy:	AS BUILT

Project No:	A637
Drawing:	1

RAL RD



Master

Existing Conduit

Riser Pipe



Designed:	EEC
Drawn:	EEC
Checked:	MLR
Edit:	12-4-2017

Title:	50031 - CHAPARRAL RD AT LITTLE BEAR CREEK MASTER AERIAL VIEW
Filepath:	P:\A637 Hays County TX Low Water Crossing System\AutoCADAS BUILT\FLASHERS\50031 - CHAPARRAL RD\ 50031 - CHAPARRAL RD.dwg

Scale:	NOT TO SCALE
Copy:	AS BUILT

Project No:	A637
Drawing:	2



ID	STATION NAME	DESCRIPTION	ROD (FT)	DEPTH (FT)	CALCULATED TRIGGER ELEVATION	PROGRAMMED TRIGGER ELEVATION
50031	Chaparral Rd at Little Bear Creek	Channel Bottom	15.10	-0.24	11.40	11.50
		Stop Bolt	14.86	0.00		
		Culvert Crown	6.89	7.97		
		Top of Riser	5.63	9.23		
		Edge of Road	3.46	11.40		




Designed: EEC  
 Drawn: EEC  
 Checked: MLR  
 Edit: 12-4-2017

Title: 50031 - CHAPARRAL RD AT LITTLE BEAR CREEK SURVEY & RISER DETAIL  
 Filepath: P:\A637 Hays County TX Low Water Crossing System\AutoCADAS BUILT\FLASHERS\50031 - CHAPARRAL RD\50031 - CHAPARRAL RD.dwg

Scale: NOT TO SCALE  
 Copy: AS BUILT

Project No: A637  
 Drawing: 3

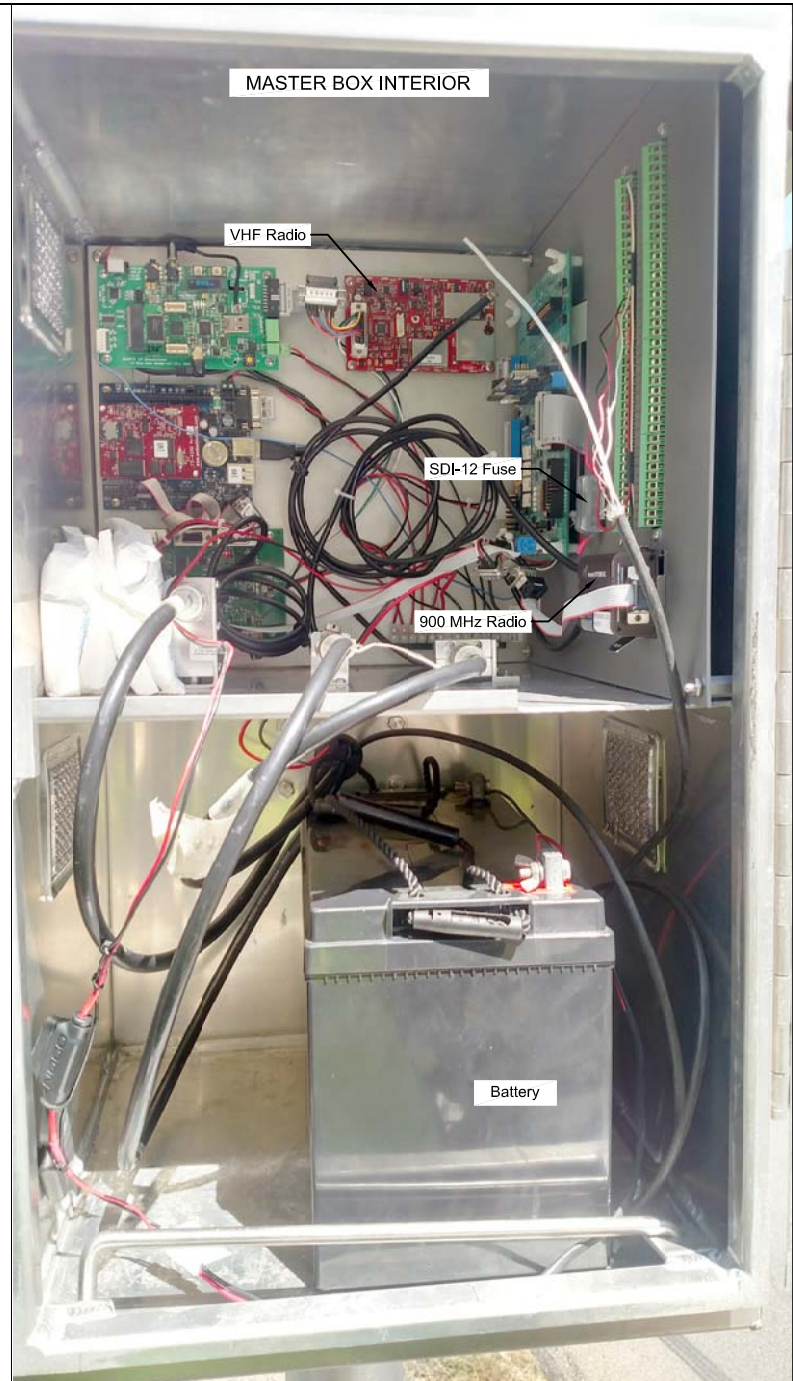

Designed:	EEC
Drawn:	EEC
Checked:	MLR
Edt:	12-4-2017

Title:	50031 - CHAPARRAL RD AT LITTLE BEAR CREEK MASTER DETAILS
	Filepath: P:\A637 Hays County TX Low Water Crossing System\AutoCAD\AS BUILT\FLASHERS\50031 - CHAPARRAL RD\50031 - CHAPARRAL RD.dwg

Scale:	NOT TO SCALE
Copy:	AS BUILT

Project No:	A637
Drawing:	4

