

Designed:	EEC
Drawn:	EEC
Checked:	MLR
Edit:	12-4-2017

Title:	50035 - BELL SPRINGS RD AT BARTON CREEK SITE AERIAL VIEW
Filepath:	P:\A637 Hays County TX Low Water Crossing System\AutoCADAS BUILT\FLASHERS\50035 - BELL SPRINGS RD AT BARTON CREEK\50035 - BELL SPRINGS RD.dwg

Scale:	NOT TO SCALE
Copy:	AS BUILT

Project No:	A637
Drawing:	1



36 Rd

Riser Pipe

Existing Conduit

169

Master




Designed:	EEC
Drawn:	EEC
Checked:	MLR
Edit:	12-4-2017

Title:	50035 - BELL SPRINGS RD AT BARTON CREEK MASTER AERIAL VIEW
Filepath:	P:\A637 Hays County TX Low Water Crossing System\AutoCADAS BUILT\FLASHERS\50035 - BELL SPRINGS RD AT BARTON CREEK\50035 - BELL SPRINGS RD.dwg

Scale:	NOT TO SCALE
Copy:	AS BUILT

Project No:	A637
Drawing:	2

ID	STATION NAME	DESCRIPTION	ROD (FT)	DEPTH (FT)	CALCULATED TRIGGER ELEVATION	PROGRAMMED TRIGGER ELEVATION
50035	Bell Springs Rd (CR 169) at Barton Creek	Channel Bottom	12.13	0.44	1.91	1.81
		Stop Bolt	12.57	0.00		
		Top of Riser	10.75	1.82		
		Culvert Crown	10.47	2.10		
		Edge of Road	10.66	1.91		

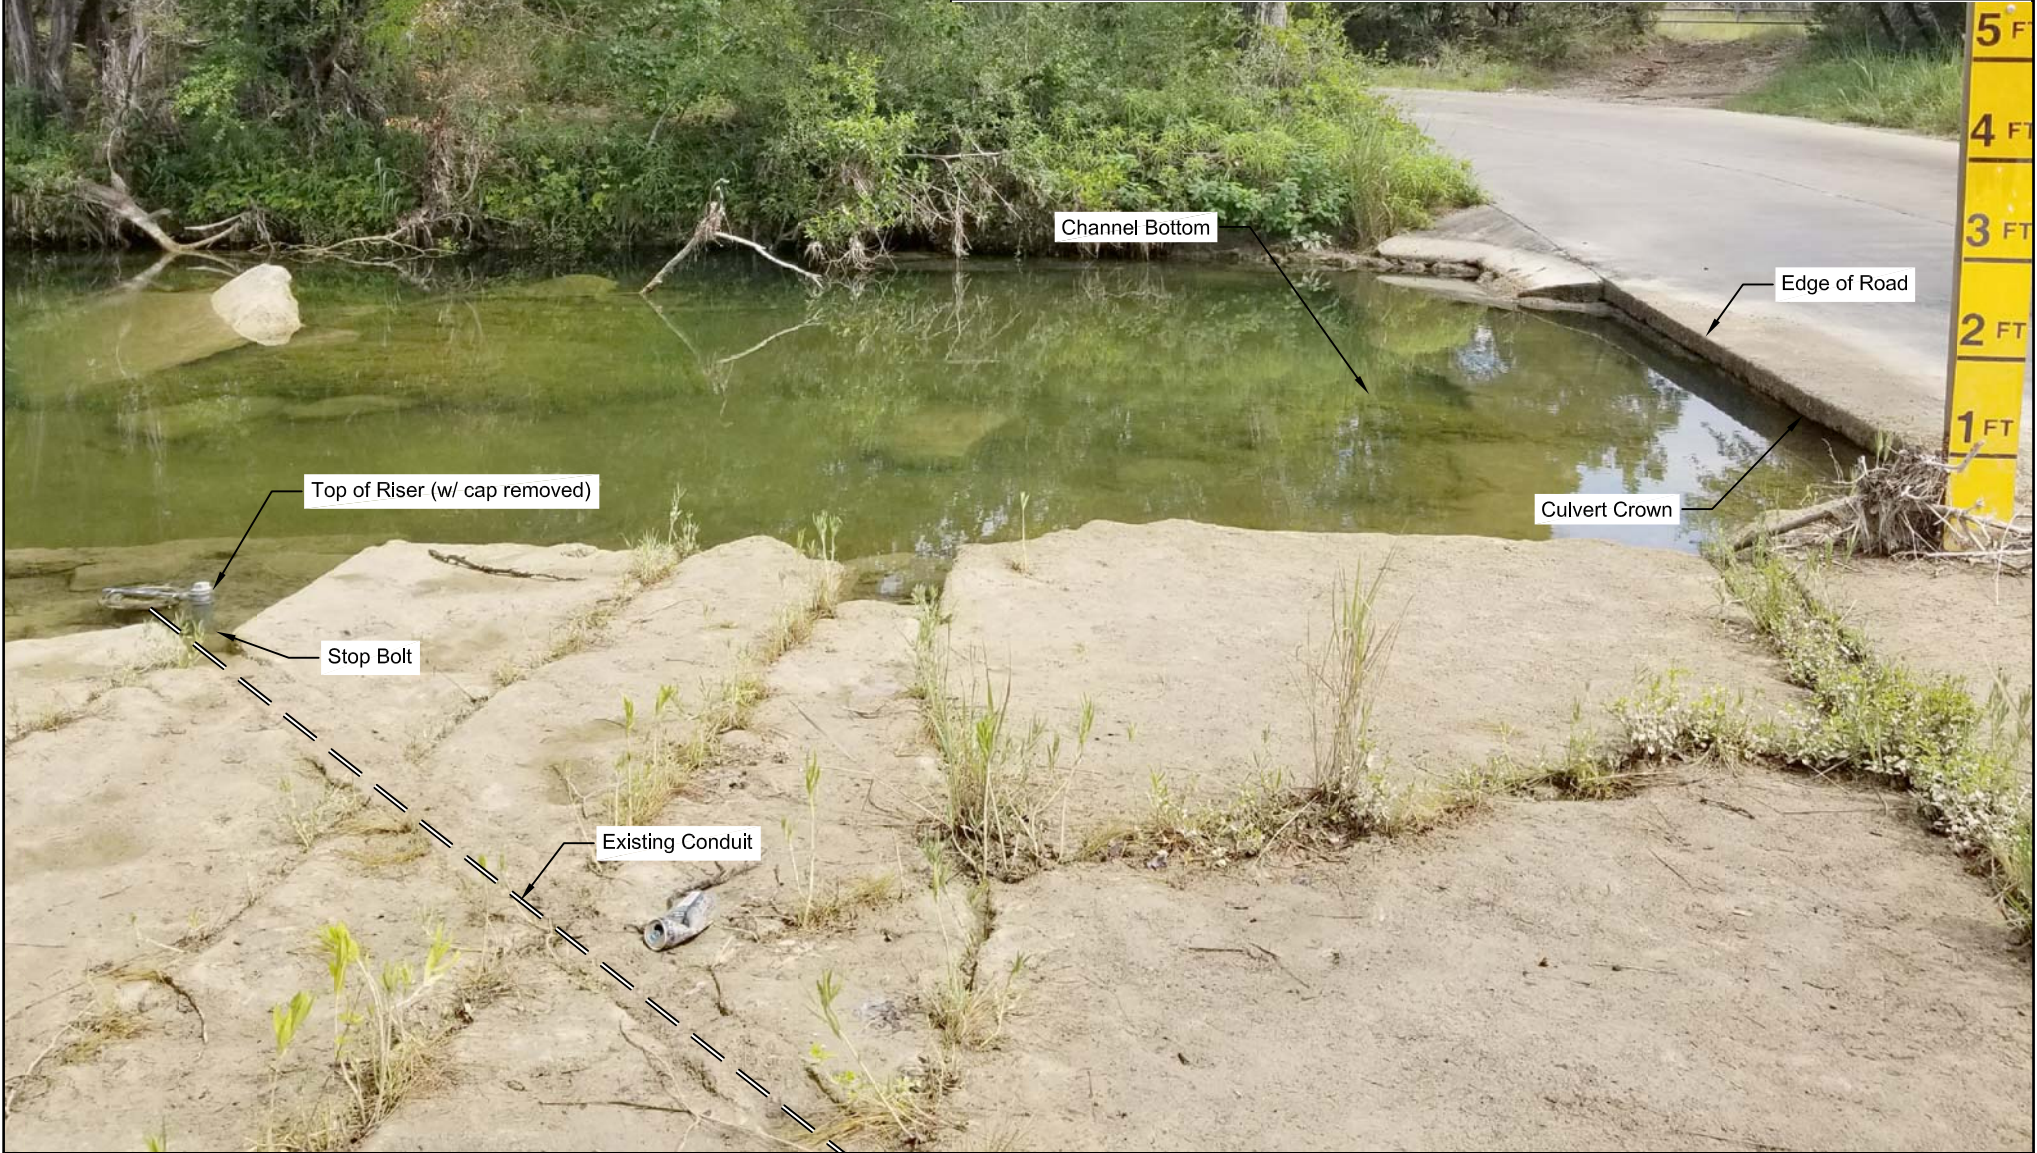


Designed:	EEC
Drawn:	EEC
Checked:	MLR
Edit:	12-4-2017

Title:	50035 - BELL SPRINGS RD AT BARTON CREEK SURVEY DETAILS
Filepath:	P:\A637 Hays County TX Low Water Crossing System\AutoCADAS BUILT\FLASHERS\50035 - BELL SPRINGS RD AT BARTON CREEK\50035 - BELL SPRINGS RD.dwg

Scale:	NOT TO SCALE
Copy:	AS BUILT

Project No:	A637
Drawing:	3

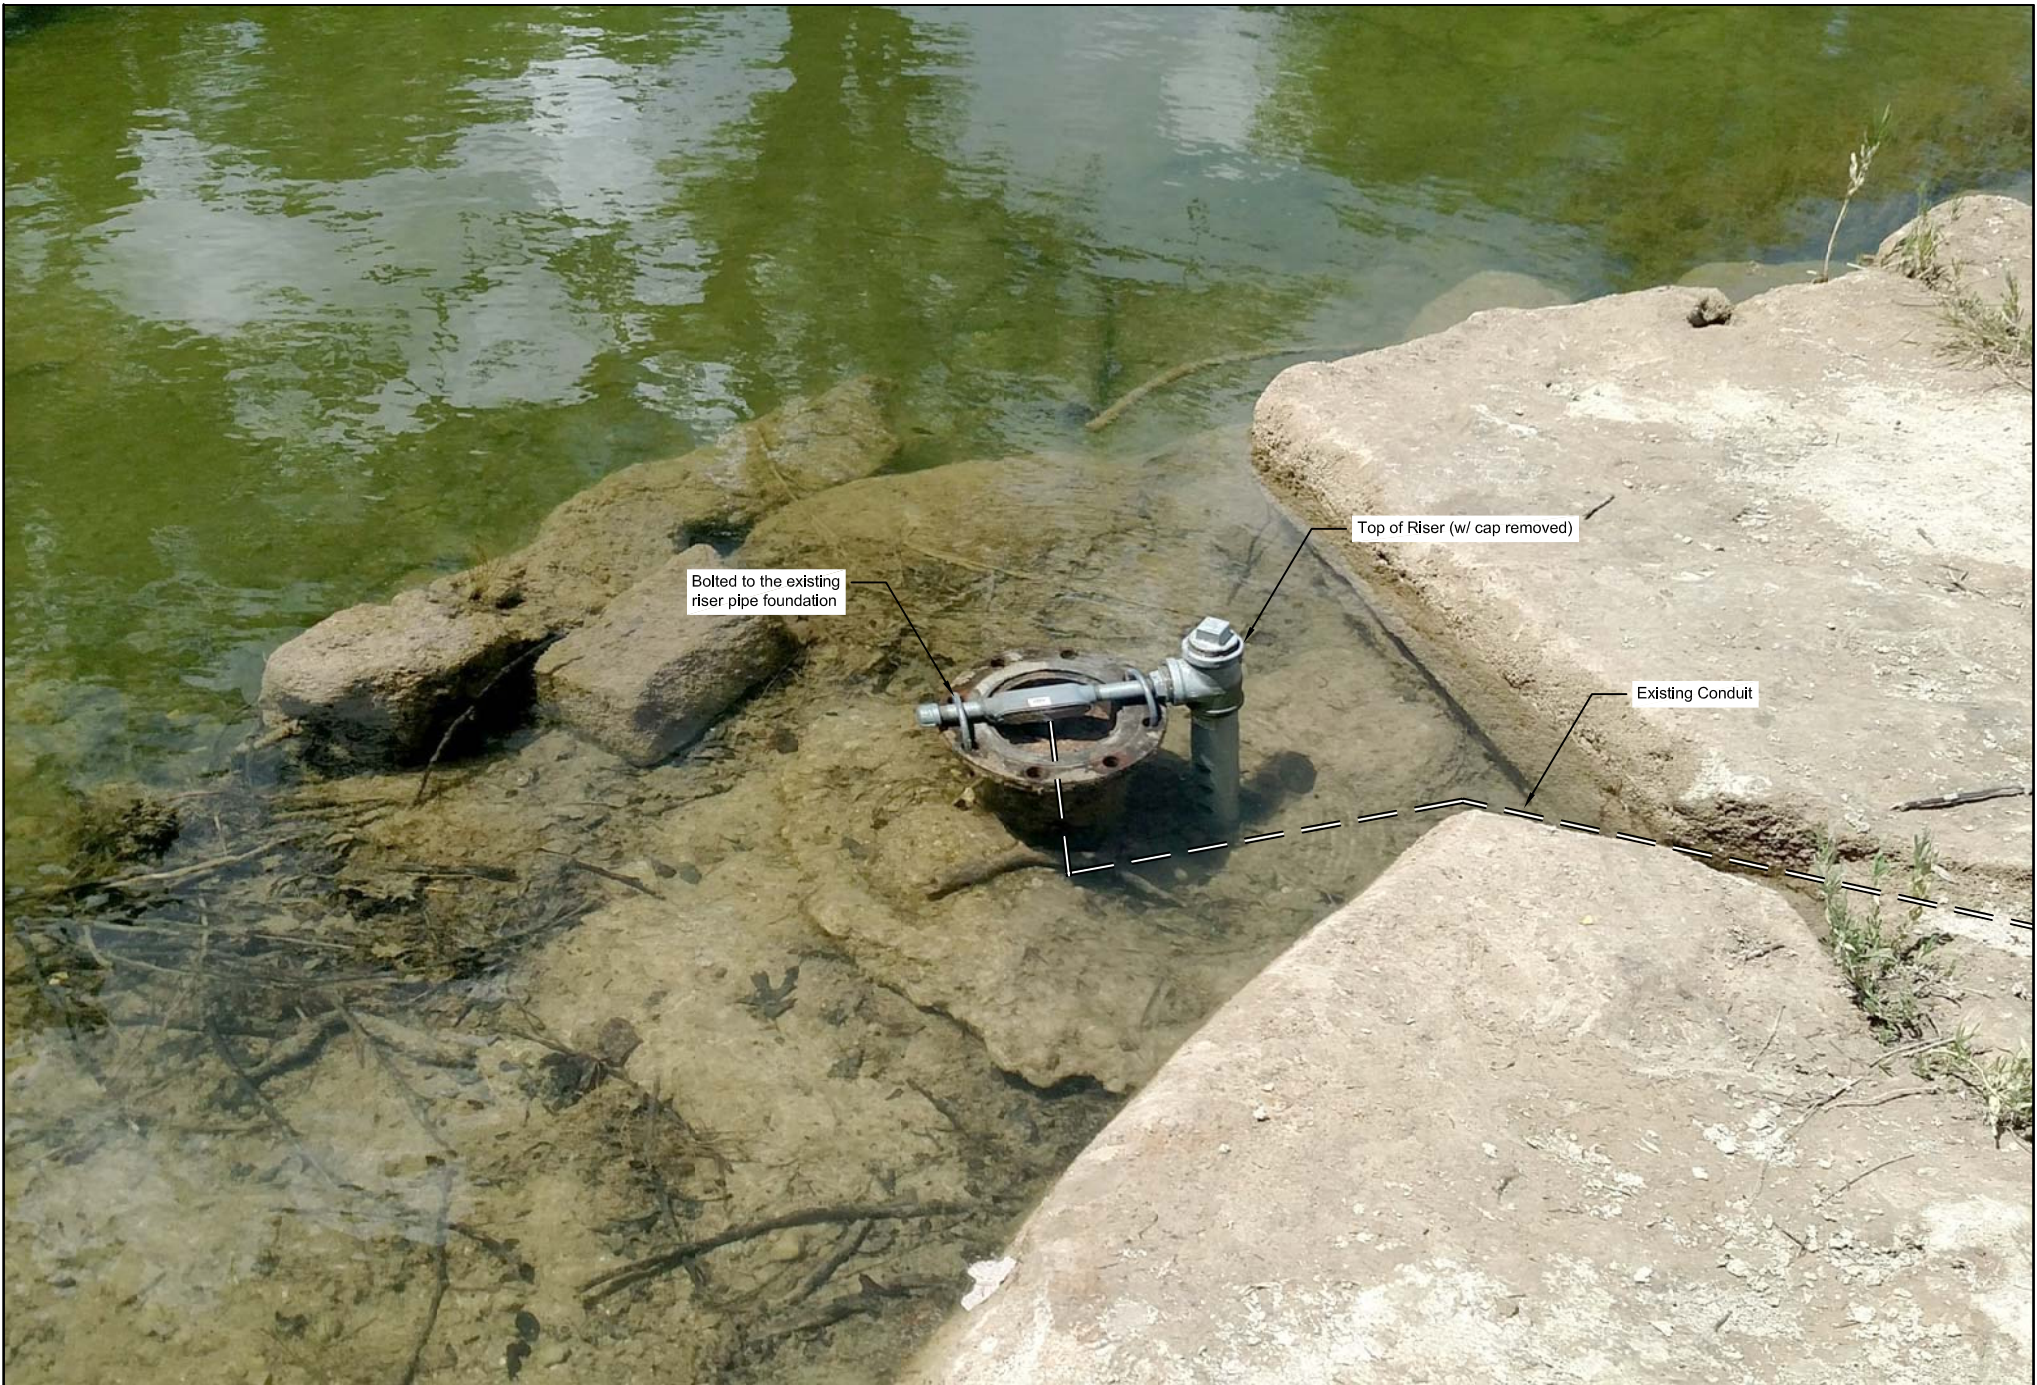

Designed:	EEC
Drawn:	EEC
Checked:	MLR
Edit:	12-4-2017

Title:	50035 - BELL SPRINGS RD AT BARTON CREEK RISER PIPE DETAILS
Filepath:	P:\A637 Hays County TX Low Water Crossing System\AutoCAD\AS BUILT\FLASHERS\50035 - BELL SPRINGS RD AT BARTON CREEK\50035 - BELL SPRINGS RD.dwg

Scale:	NOT TO SCALE
Copy:	AS BUILT

Project No:	A637
Drawing:	4

