



Designed:	EEC
Drawn:	EEC
Checked:	MLR
Edit:	11-30-2017

Title:	50038 - RAEFORD CROSSING AT PEDERNALES TRIBUTARY SITE AERIAL VIEW
Filepath:	P:\A637 Hays County TX Low Water Crossing System\AutoCADAS BUILT\FLASHERS\50038 - RAEFORD CROSSING\50038 - RAEFORD CROSSING.dwg

Scale:	NOT TO SCALE
Copy:	AS BUILT

Project No:	A637
Drawing:	1

CROSSING




Designed:	EEC
Drawn:	EEC
Checked:	MLR
Edit:	11-30-2017

Title:	50038 - RAEFORD CROSSING AT PEDERNALES TRIBUTARY MASTER FLASHER AERIAL VIEW
Filepath:	P:\A637 Hays County TX Low Water Crossing System\AutoCADAS BUILT\FLASHERS\50038 - RAEFORD CROSSING\50038 - RAEFORD CROSSING.dwg

Scale:	NOT TO SCALE
Copy:	AS BUILT

Project No:	A637
Drawing:	2

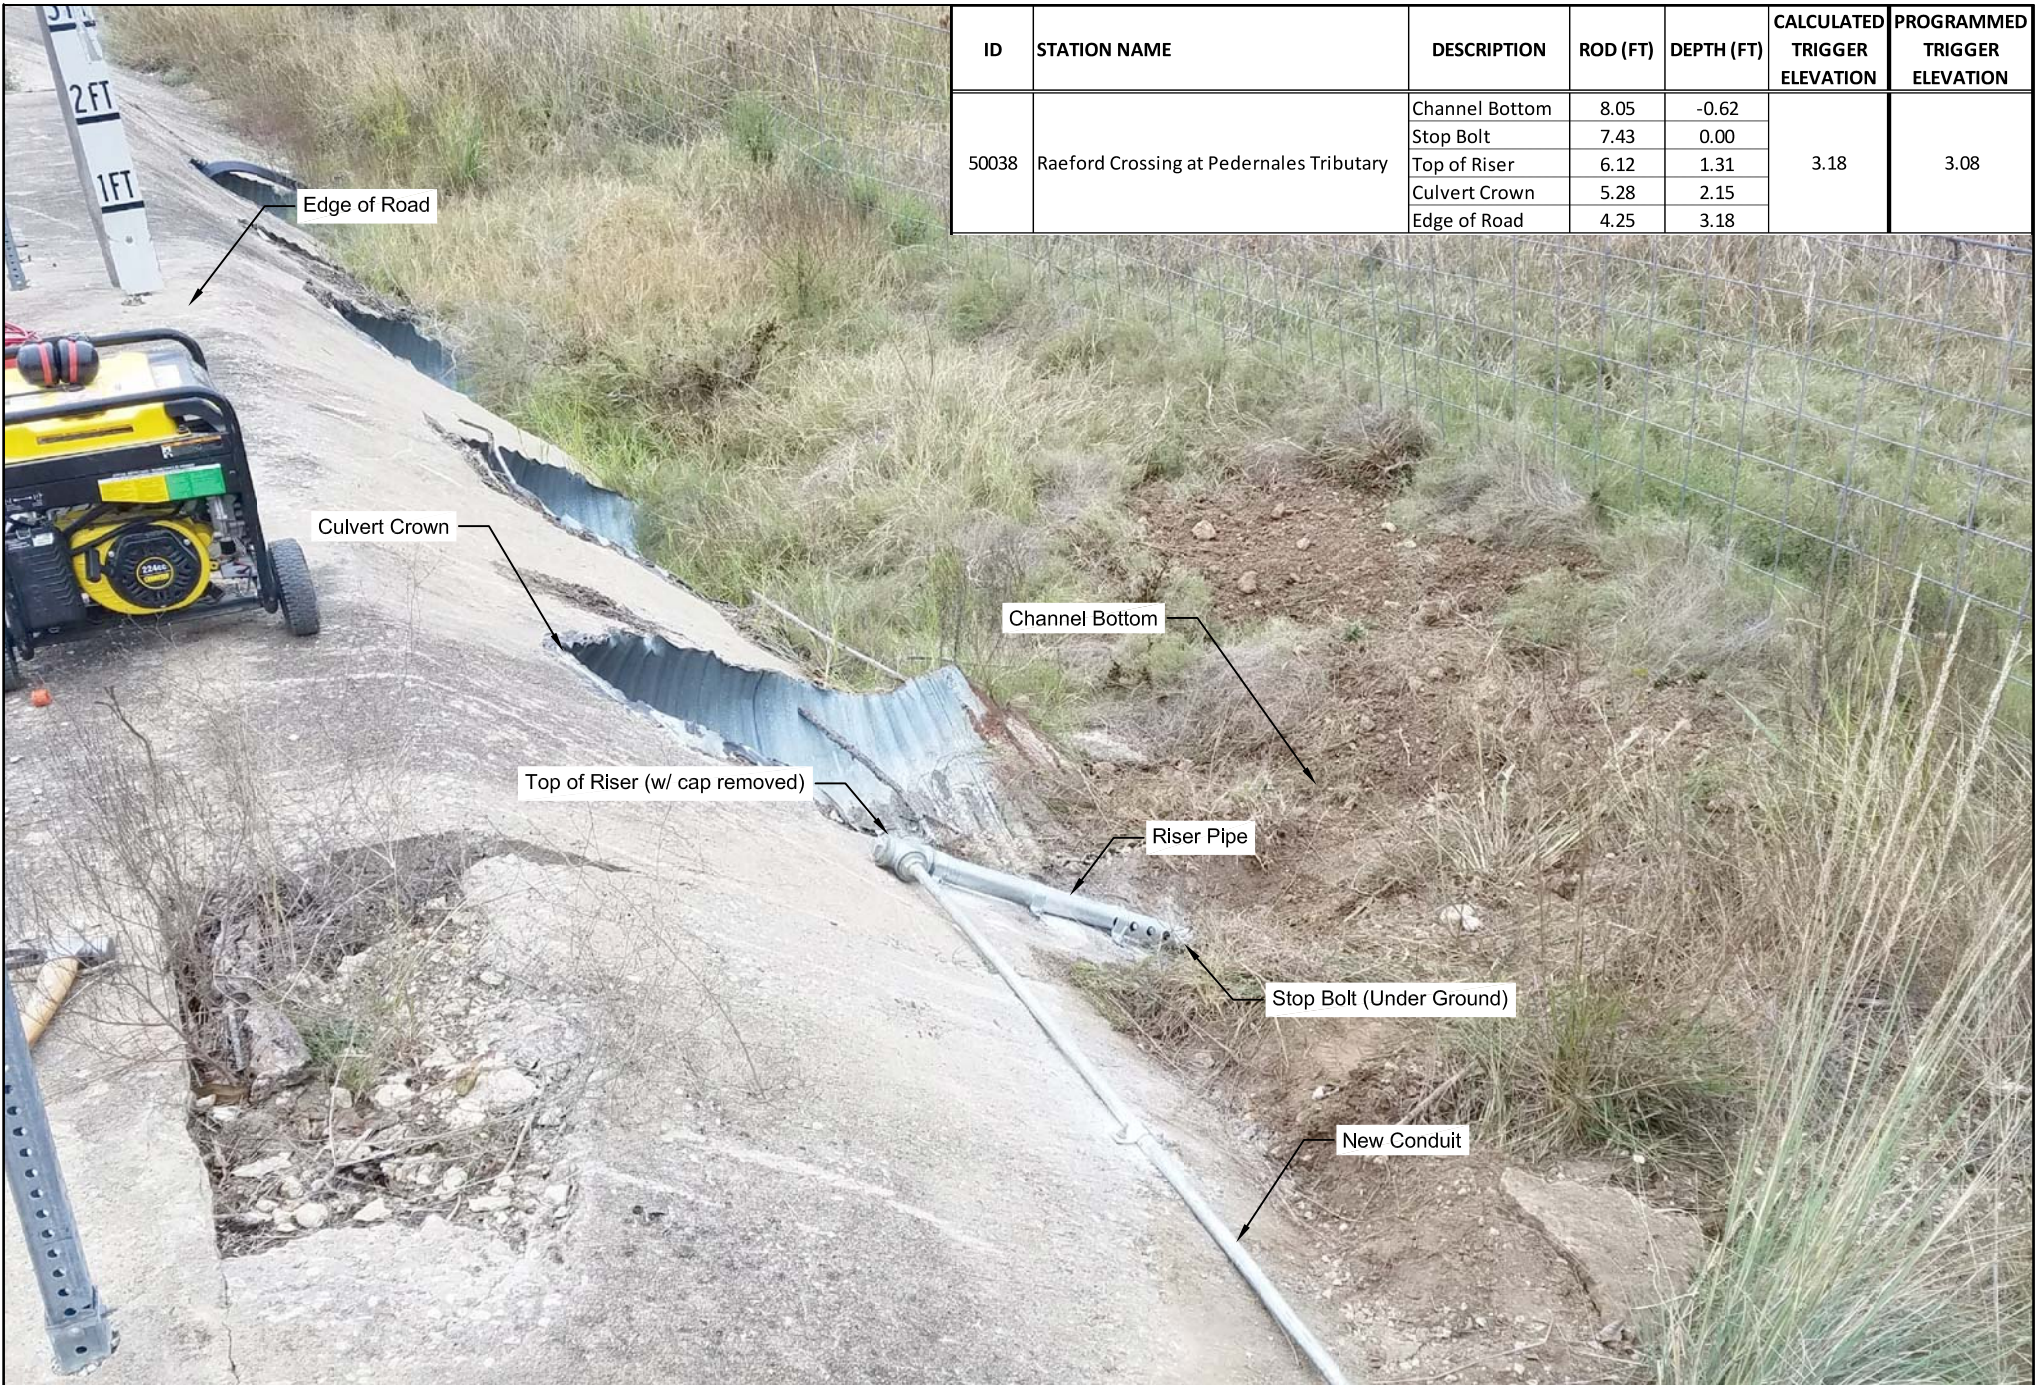

ID	STATION NAME	DESCRIPTION	ROD (FT)	DEPTH (FT)	CALCULATED TRIGGER ELEVATION	PROGRAMMED TRIGGER ELEVATION
50038	Raeford Crossing at Pedernales Tributary	Channel Bottom	8.05	-0.62	3.18	3.08
		Stop Bolt	7.43	0.00		
		Top of Riser	6.12	1.31		
		Culvert Crown	5.28	2.15		
		Edge of Road	4.25	3.18		



Designed:	EEC
Drawn:	EEC
Checked:	MLR
Edt:	11-30-2017

Title:	50038 - RAEFORD CROSSING AT PEDERNALES TRIBUTARY RISER & SURVEY DETAILS
Filepath:	P:\A637 Hays County TX Low Water Crossing System\AutoCADAS BUILT\FLASHERS\50038 - RAEFORD CROSSING\50038 - RAEFORD CROSSING.dwg

Scale:	NOT TO SCALE
Copy:	AS BUILT

Project No:	A637
Drawing:	3



New Conduit



Designed:	EEC
Drawn:	EEC
Checked:	MLR
Edit:	11-30-2017

Title:	50038 - RAEFORD CROSSING AT PEDERNALES TRIBUTARY CONDUIT DETAILS #1
Filepath:	P:\A637 Hays County TX Low Water Crossing System\AutoCADAS BUILT\FLASHERS\50038 - RAEFORD CROSSING\50038 - RAEFORD CROSSING.dwg

Scale:	NOT TO SCALE
Copy:	AS BUILT

Project No:	A637
Drawing:	4



Designed:	EEC
Drawn:	EEC
Checked:	MLR
Edit:	11-30-2017

Title:	50038 - RAEFORD CROSSING AT PEDERNALES TRIBUTARY CONDUIT DETAILS #2
Filepath:	P:\A637 Hays County TX Low Water Crossing System\AutoCADAS BUILT\FLASHERS\50038 - RAEFORD CROSSING\50038 - RAEFORD CROSSING.dwg

Scale:	NOT TO SCALE
Copy:	AS BUILT

Project No:	A637
Drawing:	5



New Conduit



Designed:	EEC
Drawn:	EEC
Checked:	MLR
Edit:	11-30-2017

Title:	50038 - RAEFORD CROSSING AT PEDERNALES TRIBUTARY CONDUIT DETAILS #3
Filepath:	P:\A637 Hays County TX Low Water Crossing System\AutoCAD\AS BUILT\FLASHERS\50038 - RAEFORD CROSSING\50038 - RAEFORD CROSSING.dwg

Scale:	NOT TO SCALE
Copy:	AS BUILT

Project No:	A637
Drawing:	6



New Conduit

Conduit Access Box



Designed:	EEC
Drawn:	EEC
Checked:	MLR
Edit:	11-30-2017

Title:	50038 - RAEFORD CROSSING AT PEDERNALES TRIBUTARY CONDUIT DETAILS #4
Filepath:	P:\A637 Hays County TX Low Water Crossing System\AutoCADAS BUILT\FLASHERS\50038 - RAEFORD CROSSING\50038 - RAEFORD CROSSING.dwg

Scale:	NOT TO SCALE
Copy:	AS BUILT

Project No:	A637
Drawing:	7

