

Designed:	EEC
Drawn:	EEC
Checked:	MLR
Edit:	11-27-2017

Title:	50040 - CREEK RD & MT GAINOR RD AT ONION CREEK SITE AERIAL VIEW
Filepath:	P:\A637 Hays County TX Low Water Crossing System\AutoCADAS BUILT\FLASHERS\50040 - CREEK RD & MT GAINOR RD AT ONION CREEK\50040 - CREEK RD & MT GAINOR.dwg

Scale:	NOT TO SCALE
Copy:	AS BUILT

Project No:	A637
Drawing:	1




Designed:	EEC
Drawn:	EEC
Checked:	MLR
Edit:	11-27-2017


Title:	50040 - CREEK RD & MT GAINOR RD AT ONION CREEK MASTER FLASHER AERIAL VIEW
	Filepath: P:\A637 Hays County TX Low Water Crossing System\AutoCAD\AS BUILT\FLASHERS\50040 - CREEK RD & MT GAINOR RD AT ONION CREEK\50040 - CREEK RD & MT GAINOR.dwg

Scale:	NOT TO SCALE
Copy:	AS BUILT

Project No:	A637
Drawing:	2

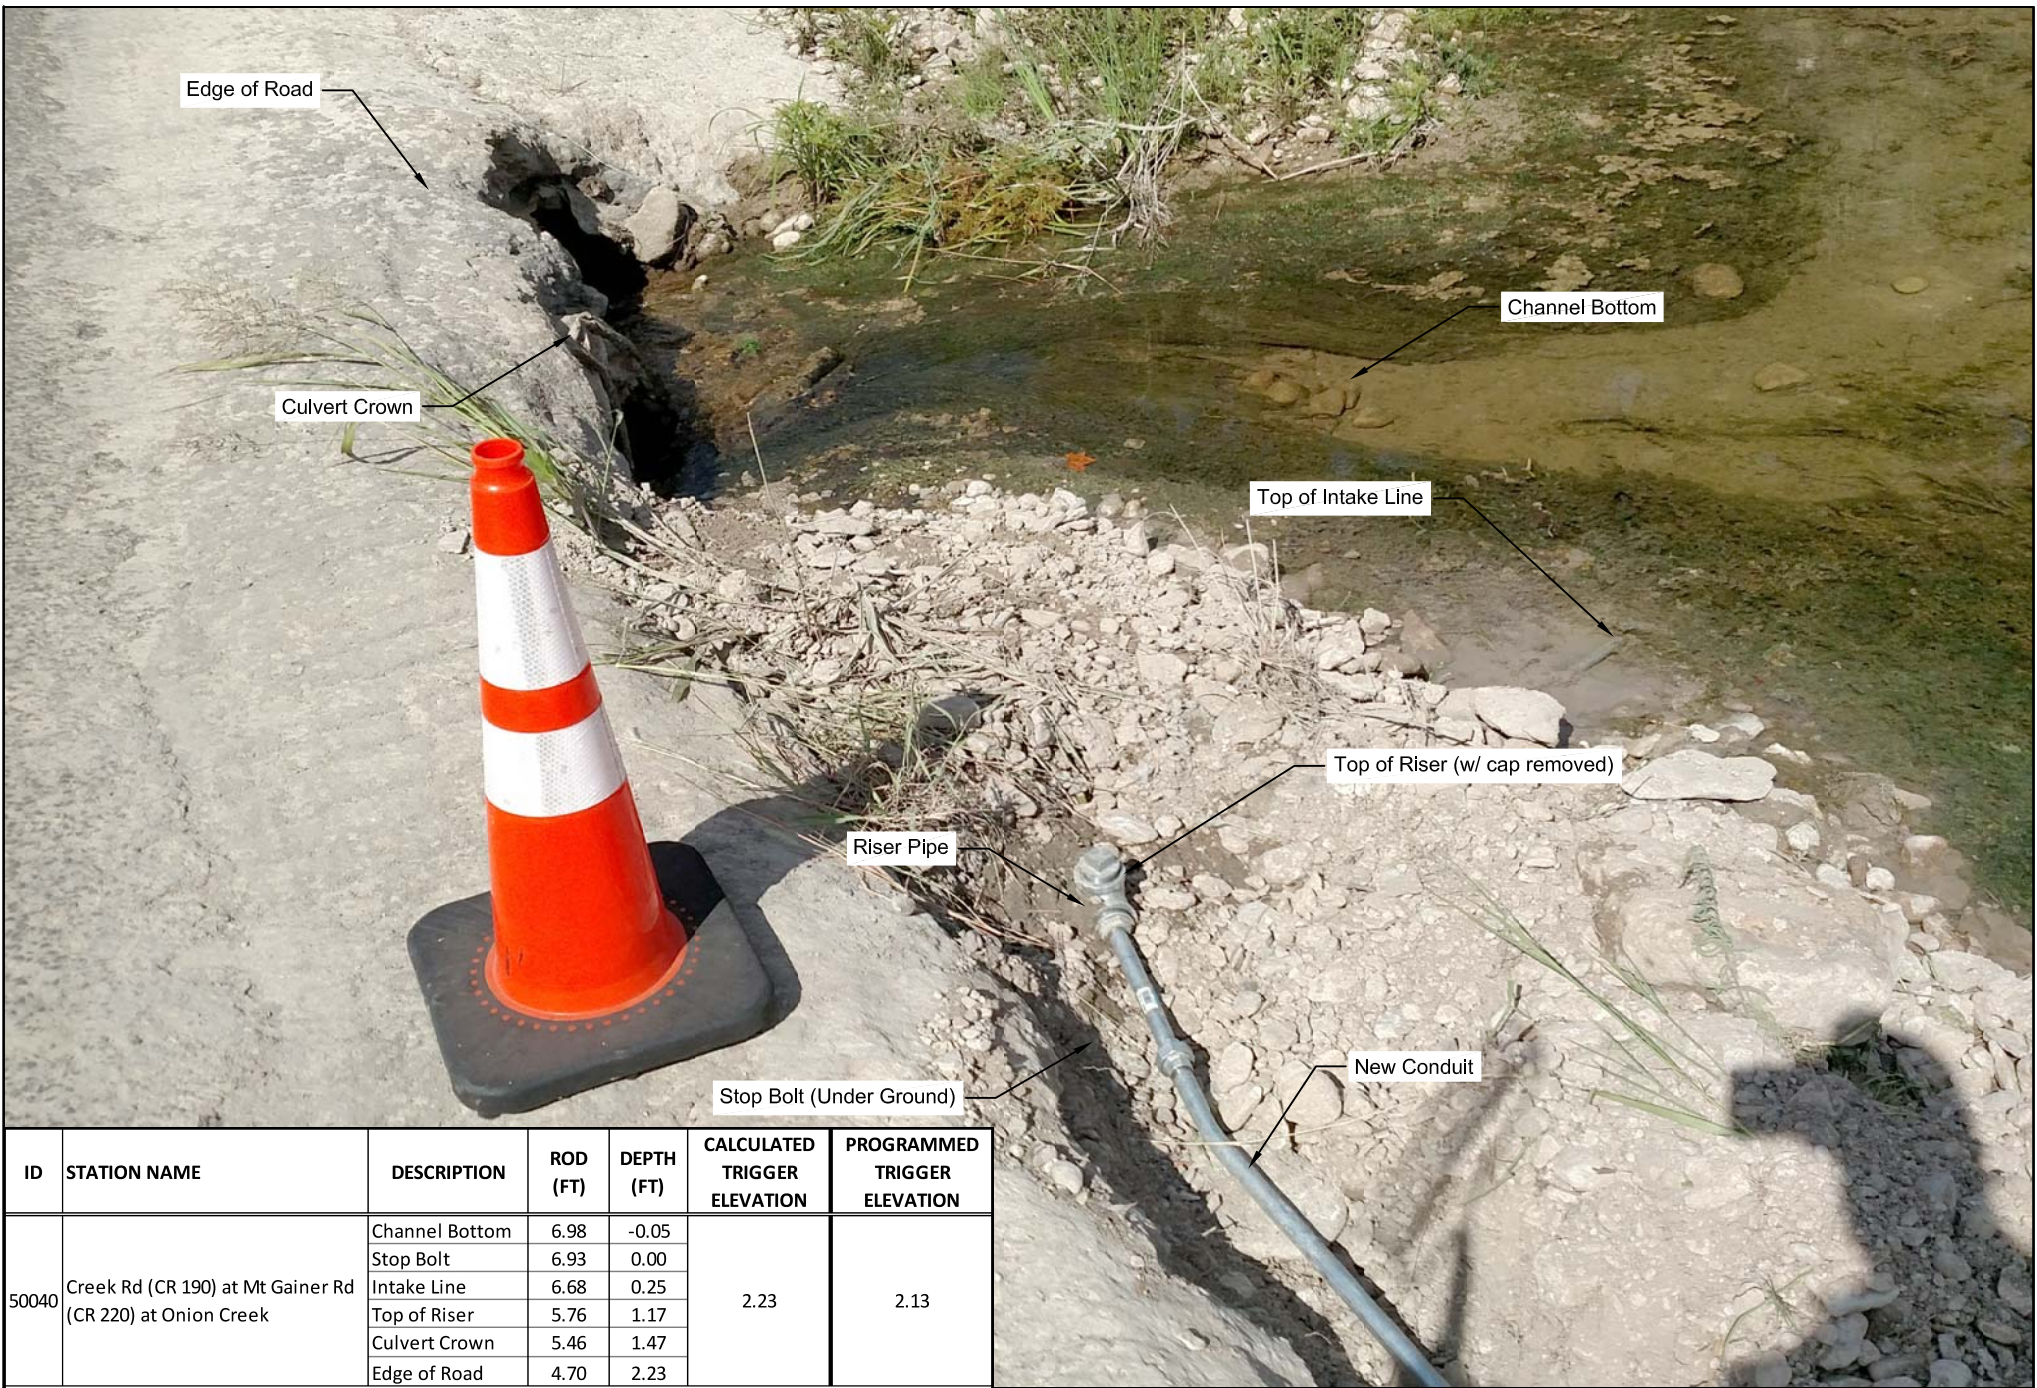

ID	STATION NAME	DESCRIPTION	ROD (FT)	DEPTH (FT)	CALCULATED TRIGGER ELEVATION	PROGRAMMED TRIGGER ELEVATION
50040	Creek Rd (CR 190) at Mt Gainer Rd (CR 220) at Onion Creek	Channel Bottom	6.98	-0.05	2.23	2.13
		Stop Bolt	6.93	0.00		
		Intake Line	6.68	0.25		
		Top of Riser	5.76	1.17		
		Culvert Crown	5.46	1.47		
		Edge of Road	4.70	2.23		

	Designed: EEC	<b>Title: 50040 - CREEK RD &amp; MT GAINOR RD AT ONION CREEK SURVEY &amp; RISER DETAIL</b>	Scale: NOT TO SCALE	Project No: A637
	Drawn: EEC		Copy: AS BUILT	Drawing: 3
	Checked: MLR			
	Edit: 11-27-2017		Filepath: P:\A637 Hays County TX Low Water Crossing System\AutoCADAS BUILT\FLASHERS\50040 - CREEK RD & MT GAINOR RD AT ONION CREEK\50040 - CREEK RD & MT GAINOR.dwg	



Riser Pipe

New Conduit



Designed:	EEC
Drawn:	EEC
Checked:	MLR
Edt:	11-27-2017

Title:	50040 - CREEK RD & MT GAINOR RD AT UNION CREEK CONDUIT DETAILS #1
	Filepath: P:\A637 Hays County TX Low Water Crossing System\AutoCADAS BUILT\FLASHERS\50040 - CREEK RD & MT GAINOR RD AT UNION CREEK\50040 - CREEK RD & MT GAINOR.dwg

Scale:	NOT TO SCALE
Copy:	AS BUILT

Project No:	A637
Drawing:	4



New Conduit



Designed: EEC	Title: 50040 - CREEK RD & MT GAINOR RD AT UNION CREEK CONDUIT DETAILS #2	Scale: NOT TO SCALE	Project No: A637
Drawn: EEC		Copy: AS BUILT	Drawing: 5
Checked: MLR			
Edit: 11-27-2017	Filepath: P:\A637 Hays County TX Low Water Crossing System\AutoCAD\AS BUILT\FLASHERS\50040 - CREEK RD & MT GAINOR RD AT UNION CREEK\50040 - CREEK RD & MT GAINOR.dwg		



New Conduit

Conduit Access Box





Designed:	EEC
Drawn:	EEC
Checked:	MLR
Edit:	11-27-2017

Title:	50040 - CREEK RD & MT GAINOR RD AT UNION CREEK CONDUIT DETAILS #3
Filepath:	P:\A637 Hays County TX Low Water Crossing System\AutoCAD\AS BUILT\FLASHERS\50040 - CREEK RD & MT GAINOR RD AT UNION CREEK\50040 - CREEK RD & MT GAINOR.dwg

Scale:	NOT TO SCALE
Copy:	AS BUILT

Project No:	A637
Drawing:	6

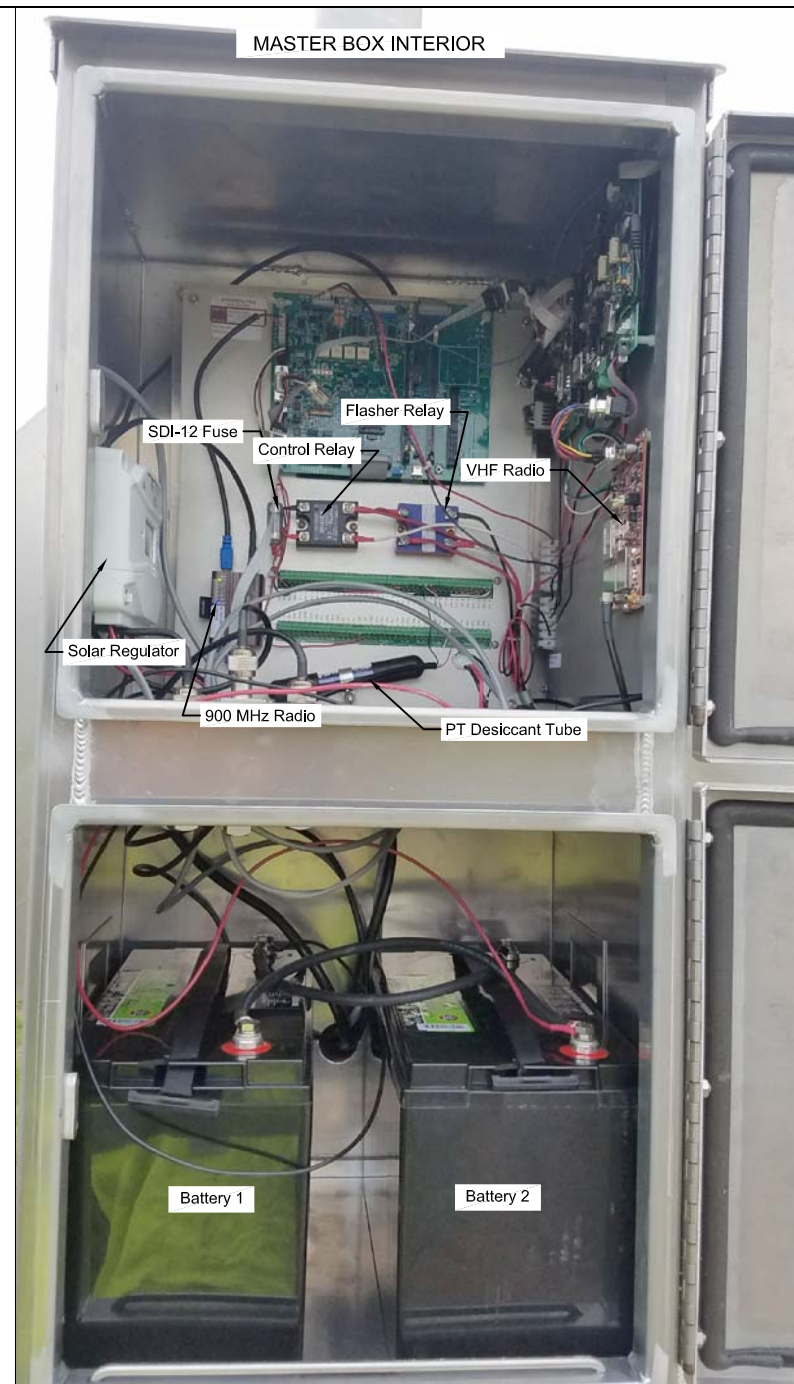

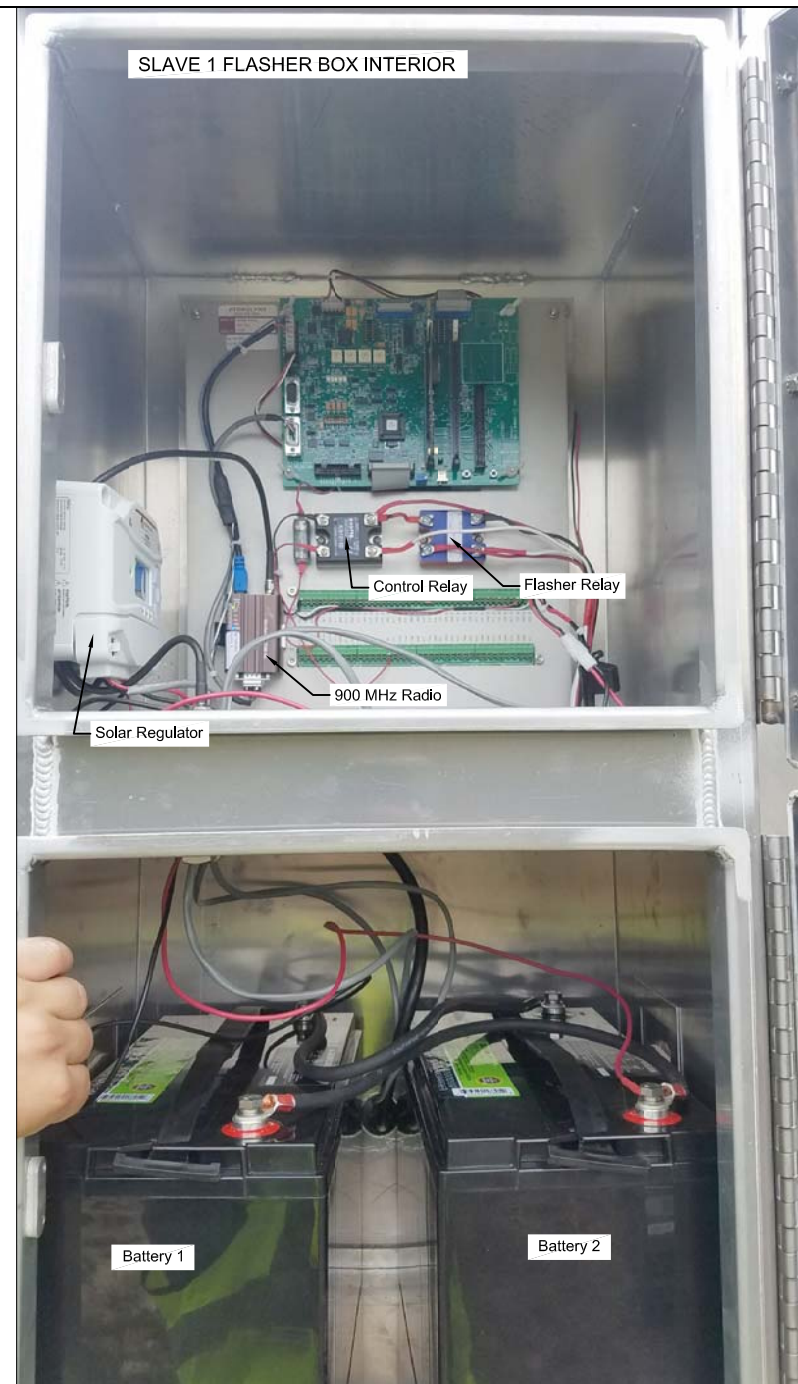

Designed: EEC  
 Drawn: EEC  
 Checked: MLR  
 Edit: 11-27-2017

Title: 50040 - CREEK RD & MT GAINOR RD  
 AT ONION CREEK  
 SLAVE FLASHER 1 DETAIL  
 Filepath: P:\A637 Hays County TX Low Water Crossing System\AutoCADAS BUILT\FLASHERS\50040 - CREEK RD & MT GAINOR RD AT ONION CREEK\50040 - CREEK RD & MT GAINOR.dwg

Scale: NOT TO SCALE  
 Copy: AS BUILT

Project No: A637  
 Drawing: 8



